

# Maine Endwell Middle School 2011

Binghamton , New York

Application Engineering by Randy Langille

Engineer/Architect      Bearsch Compeau Knudson



Mechanical Contractor      Evans Mechanical

Job Number      P7619

**AUTOMATEDLOGIC**<sup>®</sup>  
C O R P O R A T I O N

# Table of Contents


- 1: Titlepage
- 2: Table of Contents
- 3: Symbol Legend
- 4: Summary Bill of Materials
- 5: Riser
- 6: Boilers
- 7: Boilers2
- 8: Boilers3
- 9: AHU 1MS
- 10: AHU 1MS Sequence
- 11: AHU 1MS Sequence2
- 12: HRU
- 13: RTU
- 14: RTU Sequence
- 15: RTU Sequence 2
- 16: RTU Existing
- 17: RTU. E. DX
- 18: RTU Existing Sequence 1
- 19: RTU Existing Sequence 2
- 20: Make Up Air
- 21: Unit Ventilators
- 22: Unit Ventilators DX
- 23: UV DX Sequence
- 24: Fan Coils A
- 25: Fan Coil A Sequence
- 26: Fan Coil A Sequence 2
- 27: CUH/UH
- 28: CUH OUTDOOR AIR
- 29: Exhaust Fans
- 30: Exhaust Fans 2
- 31: Roof Vents
- 32: Fin Tube
- 33: Fin Tube Existing
- 34: Valve Schedule
- 35: Damper Schedule

<b>Maine Endwell Middle School 2011</b> Binghamton , New York			
 <b>AIR TEMP HEATING &amp; AIR CONDITIONING, INC.</b> <small>A LINC SERVICE ® CONTRACTOR</small>			
Table of Contents			
REV: 1	Submittal	9/29/2008	JOB NO: P7619
			CHECK BY: RSL
			DSCODE: 07112.00
			2 of 37

# Symbol Legend



Supply Fan

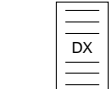


DX Cooling Coil




Duct Temperature Sensor



Exhaust Fan

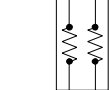

Electric Heating Coil

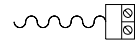


Averaging Duct Temperature Sensor




Return Fan




Gas Heating

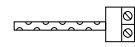

Duct Humidity Sensor

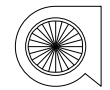


Fan w/ Inlet Vane Control

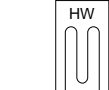

Hot Water Heating Coil




Immersion Temperature Sensor w/ Well

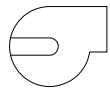


Pump




Chilled Water Cooling Coil

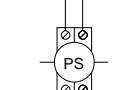


Pressure Sensor

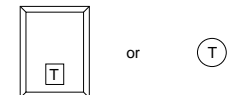


Room Temperature Sensor

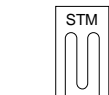


Steam Heating Coil

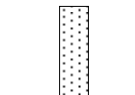


Filter

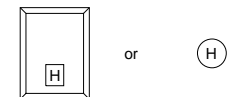


Room Humidity Sensor

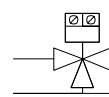


3 - Way Valve

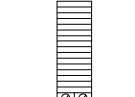


Air Flow Station

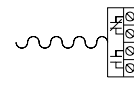


FreezeStat

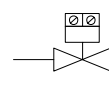


2 - Way Valve

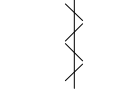

Damper

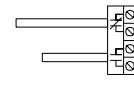

Smoke Detector

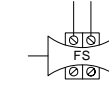

Flow Sensor

## Common Abbreviations:


AC - Air Conditioning  
 ACU - Air Conditioning Unit  
 AHU - Air Handling Unit  
 AI - Analog Input  
 AO - Analog Output  
 AUTO - Automatic  
 AUX - Auxiliary  
 C - Common  
 CHW - Chilled Water  
 CHWP - Chilled Water Pump  
 CHWR - Chilled Water Return  
 CHWS - Chilled Water Supply  
 COND - Condenser  
 CW - Condenser Water  
 CWP - Condenser Water Pump  
 CWR - Condenser Water Return  
 CWS - Condenser Water Supply  
 DA - Discharge Air  
 DI - Digital Input  
 DO - Digital Output  
 EA - Exhaust Air  
 EF - Exhaust Fan

EVAP - Evaporator  
 F - Fahrenheit  
 FCU - Fan Coil Unit  
 HOA - Hand / Off / Auto  
 HP - Heat Pump  
 HRU - Heat Recovery Unit  
 HTEX - Heat Exchanger  
 HW - Hot Water  
 HWP - Hot Water Pump  
 HWR - Hot Water Return  
 HWS - Hot Water Supply  
 MAX - Maximum  
 MIN - Minimum  
 MISC - Miscellaneous  
 NC - Normally Closed  
 NO - Normally Open  
 OA - Outdoor Air  
 PIU - Powered Induction Unit  
 RA - Return Air  
 RF - Return Fan  
 RH - Relative Humidity  
 RTU - Roof-top Unit

SA - Supply Air  
 SF - Supply Fan  
 SP - Static Pressure  
 TEMP - Temperature  
 UH - Unit Heater  
 UV - Unit Ventilator  
 VAV - Variable Air Volume  
 VVTU - Variable Volume Terminal Unit  
 W/ - with  
 W/O - without  
 WSHP - Water-Source Heat Pump

## General Notes:

- All control modules are drawn using standard ALC module representations.
- Electrical points are identified by a tagged method (LN# - LG - CM - EX - Z0):

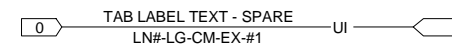



LN# - The line number (optional).  
 LG - The gateway number (optional).  
 CM - The control module address.  
 EX - The expander module number.  
 #1 - The channel number.

These tags include wiring for all AI's, DI's, AO's and DO's. Points using pneumatic tubing follow the same convention.


Maine Endwell Middle School 2011 Binghamton, New York			
 A LINC SERVICE @ CONTRACTOR			
Symbol Legend			
REV: 1	Submittal	9/29/2008	JOB NO: P7619
			CHECK BY: RSL
			DSCODE: 07112.00
			3 of 37

# Summary Bill of Materials

Summary Bill of Materials				
DID	DESCRIPTION	MANUFACTURER	PART NUMBER	QTY
AAR	ARCNET TO ARCNET ROUTER	AUTOMATED LOGIC	AAR	1 ea
CS-E	CURRENT SWITCH .5-200 AMP SOLID CORE GO/NO GO	VERUS IND.	H-800	128 ea
DA-AB	SR OPEN/CLOSE 133 IN-LB 120V	BELIMO	AF120 ALC	1 ea
DA-AC	NSR PROPORTIONAL 35 IN-LB 24 V	BELIMO	LM24-SR ALC	2 ea
DA-B	SR PROPORTIONAL 133 IN-LB 2-10VDC	BELIMO	AF24-SR ALC	1 ea
DA-CE	SR 0-10VDC 35 IN-LB 24 V	BELIMO	LF24-SR ALC	132 ea
DIAG485	ARC156 DIAGNOSTIC DEVICE	AUTOMATED LOGIC	DIAG485	1 ea
DPT-AD	DIFF PRESSURE TRANSDUCER 0-100 PSI 4-20MA	CONTRACTORS INST	P853D-(0-75#)-R-(0-100#)	1 ea
DTS-A	DUCT 10K THERMISTOR PROBE 12 IN.	BAPI	ALC/10K-2-D-12	27 ea
DTS-B	DUCT 10K THERMISTOR AVERAGING 12 FT.	BAPI	ALC/10K-2-A-12	19 ea
DTS-D	DUCT 10K THERMISTOR PROBE 8 IN.	BAPI	ALC/10K-2-D-8	66 ea
DTS-F	DUCT 10K THERMISTOR AVERAGING 8 FT.	BAPI	ALC/10K-2-A-8	66 ea
E-A	CIRCLE AW NEMA 1 20X20X6	CIRCLE AW	20206-1	1 ea
EQ-PRTL	EQUIPMENT PORTAL	AUTOMATED LOGIC	EQ-PRTL	7 ea
FS-C	FLOW SWITCH (STANDARD FLOW RATE - SPDT)	JOHNSON CONTROLS	F61KB-11	3 ea
FS-D	TEMP LOW LIMIT MAN. RESET DPDT	LANDIS STEAFA	1341504	15 ea
H-A	ALARM HORN 24VAC	FEDERAL/DELTA	350024-30	1 ea
IAQ-AB	CO SPACE SENSOR 0-200 PPM 4-20MA	R.E. TECH	WCO-1B	1 ea
LGR25	LGR25	AUTOMATED LOGIC	LGR25	1 ea
LSPLUS	LOGISTAT 10K ROOM SENSOR W/ SETP ADJ, TLO, COMM	BAPI	LSPLUS	59 ea
M0100	M0100	AUTOMATED LOGIC	M0100	1 ea
MX880	MX880	AUTOMATED LOGIC	MX880	1 ea
OAC-A	OA TEMPERATURE/HUMIDITY COMBO SENSOR	BAPI	ALC/10K-2-H220-O	1 ea
PROT485	ARC156 PROTECTION DEVICE	AUTOMATED LOGIC	PROT485	1 ea
REL-BC	PILOT RELAY 24 VAC DPDT W/ LED	OMRON	LY2N-24V	248 ea
REPT485	ARC156 REPEATER DEVICE	AUTOMATED LOGIC	REPT485	1 ea
RIBXKF	.25 TO 150 CURRENT SENSOR	FUNCTIONAL DEVICES	RIBXKF	66 ea
RS	ROOM STAT	ALC	RS	66 ea
SE6104a	SE6104A	AUTOMATED LOGIC	SE6104A	1 ea
T22AAA	LINE VOLTAGE WALL THERMOSTAT SPST	JOHNSON CONTROLS	T22AAA-1	2 ea
TC-A	HW TEMP CONTROL HIGH LIMIT MAN. RESET	JOHNSON CONTROLS	A19ADB-2	28 ea
TR-AG	TRANSFORMER, 120/24VAC 150VA W/CCT BREAKER	CORE COMPONENTS	LE-124	117 ea
ZN220	ZN220	AUTOMATED LOGIC	ZN220	46 ea
ZN253	ZN253	AUTOMATED LOGIC	ZN253	101 ea
ZN551	ZN551	AUTOMATED LOGIC	ZN551	29 ea

Maine Endwell Middle School 2011			
Binghamton , New York			
 <b>AIR TEMP HEATING &amp; AIR CONDITIONING, INC.</b> A LINC SERVICE @ CONTRACTOR			
Summary Bill of Materials			
REV: 1	Submittal	9/29/2008	JOB NO: P7619
			CHECK BY: RSL
			DSCODE: 07112.00
4 of 37			

**Riser** Maine Middle School  
Router Panel  
Boiler Room

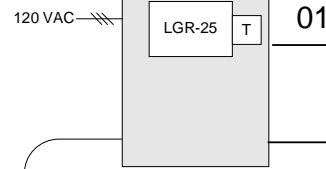


Bacnet/IP


SERVER  
admin Building

MODBUS EIA 232


AERCO BOILERS

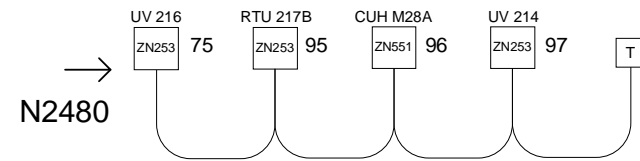


N2421

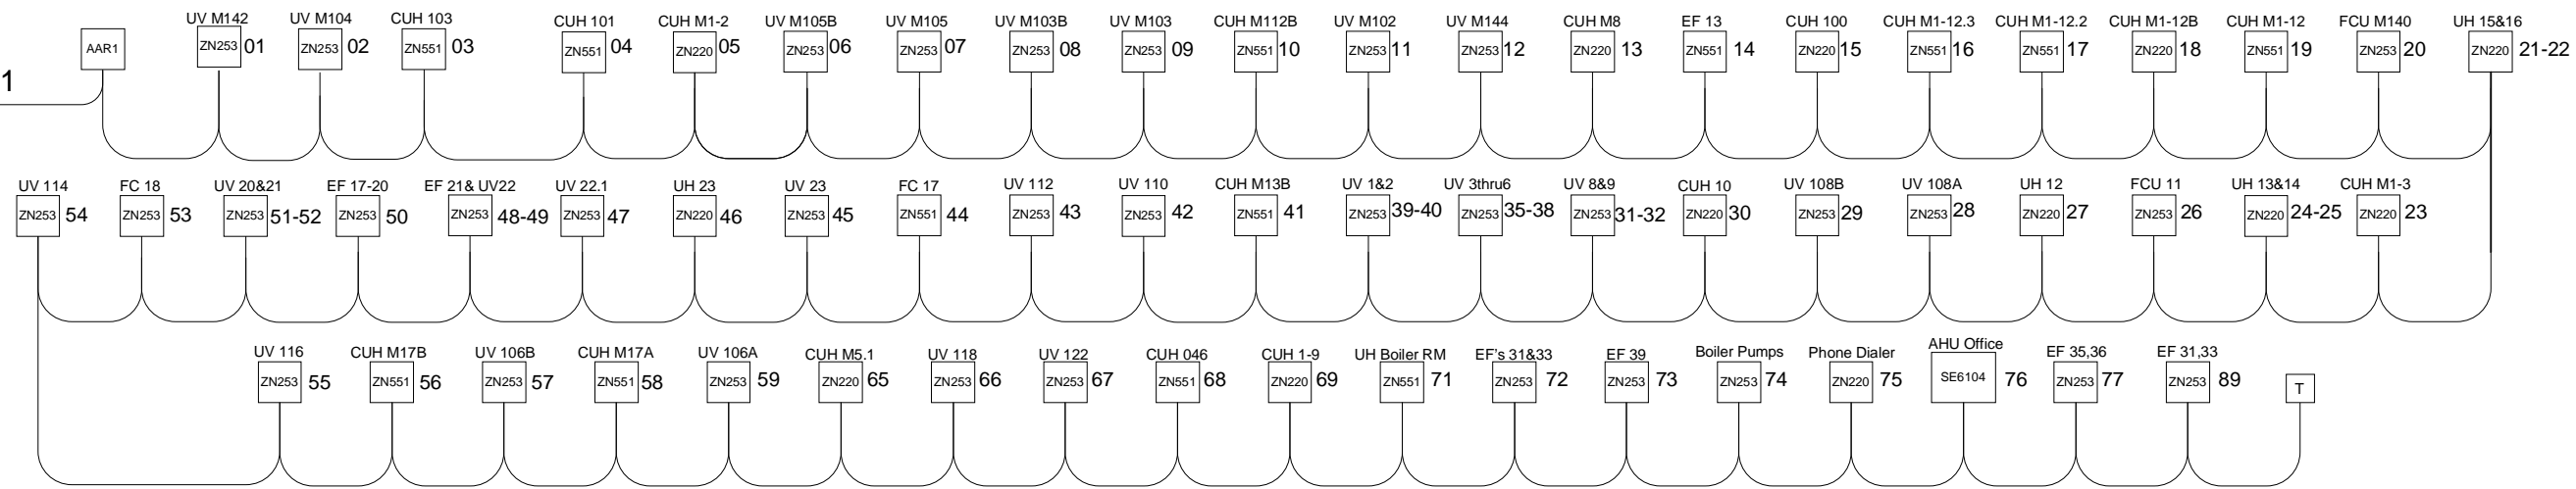

N2422

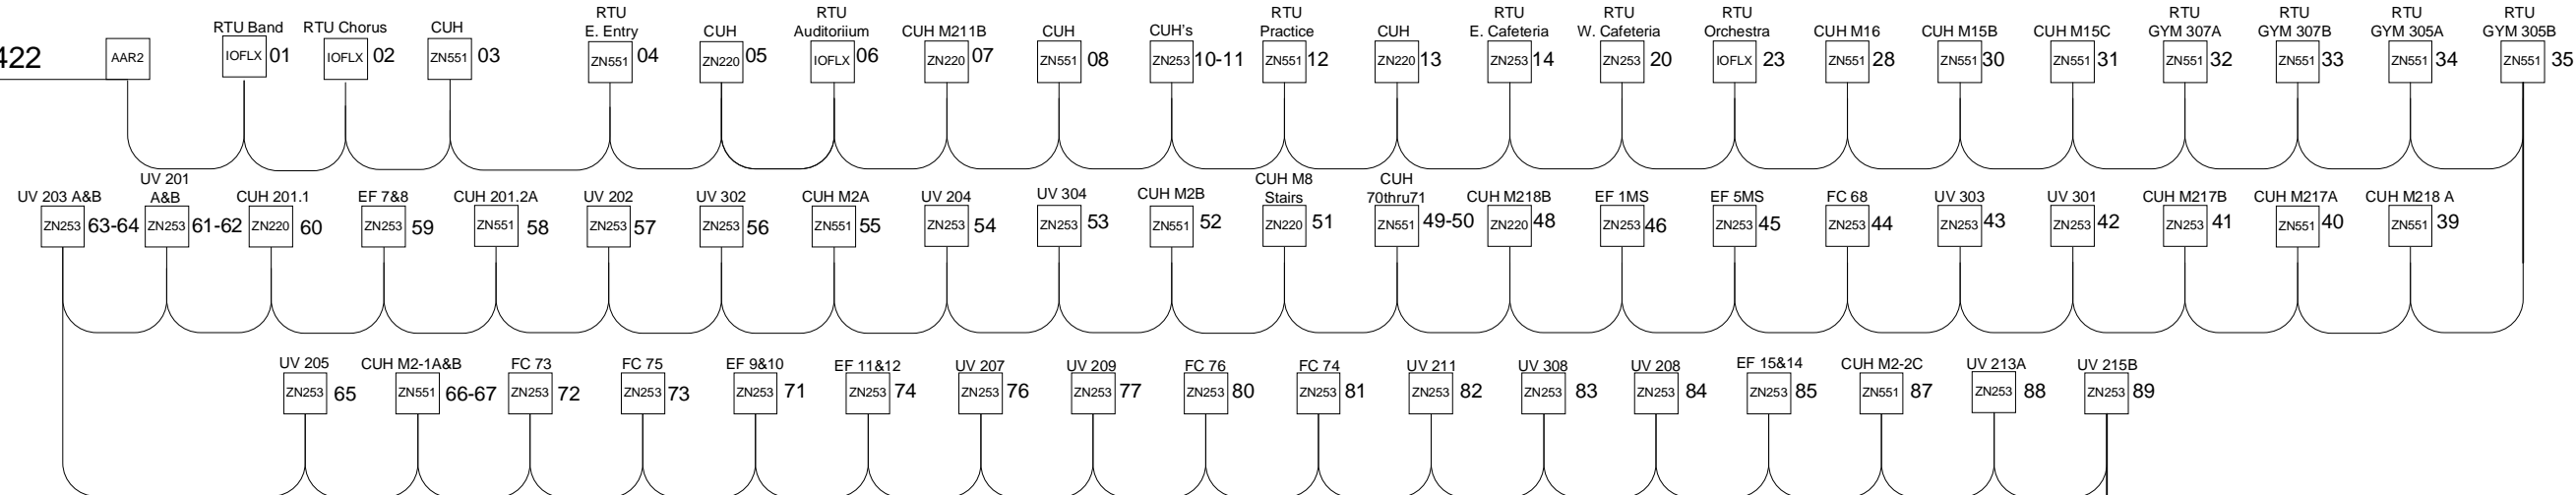

N2480

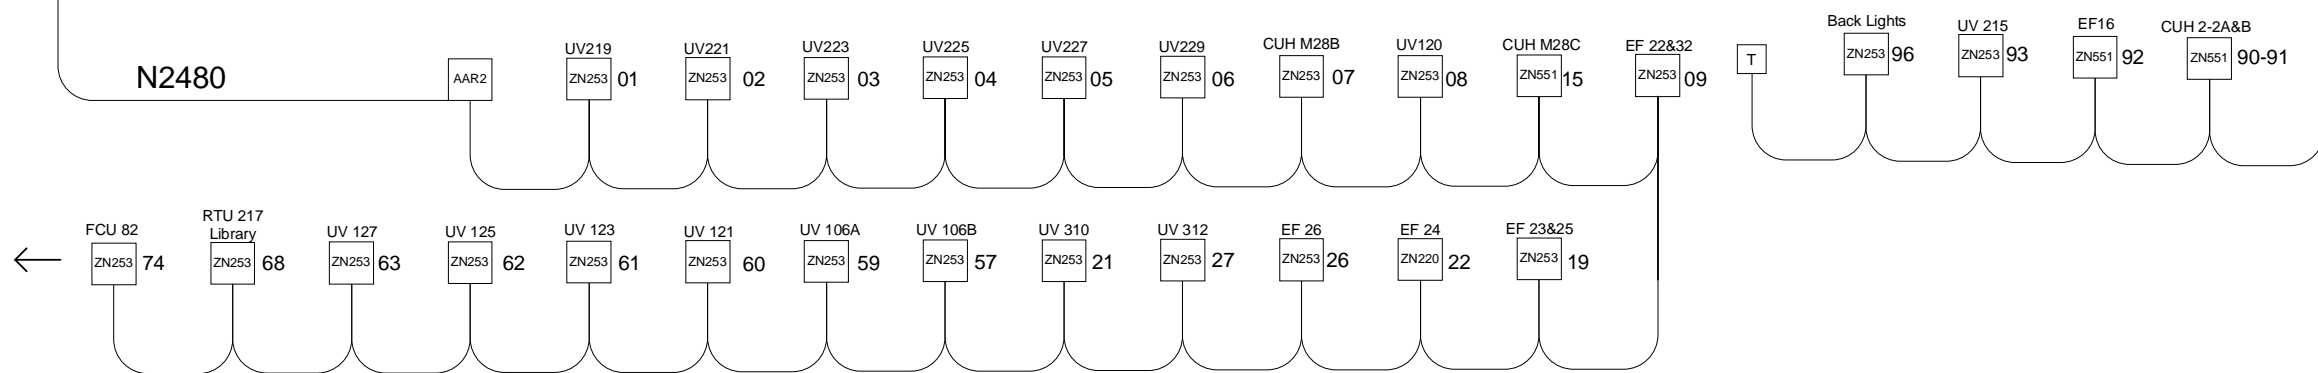


<b>Maine Endwell Middle School 2011</b> Binghamton , New York			
AIR TEMP HEATING & AIR CONDITIONING, INC. A LINC SERVICE ® CONTRACTOR			
Riser			
REV: 1	Submittal	9/29/2008	JOB NO: P7619
			CHECK BY: RSL
AUTOMATEDLOGIC CORPORATION			DSCODE: 07112.00
			5 of 37

# Boilers

**Boilers to be controlled by  
factory Aerco Boiler Panel  
C-MORE PANEL-MODBUS**

**Boiler Controls to be integrated to  
Automated Logic Via EQPRTL  
MODBUS to BACnet**

Bill of Materials				
DID	DESCRIPTION	MANUFACTURER	PART NUMBER	QTY
CS-E	CURRENT SWITCH .5-200 AMP SOLID CORE GO/NO GO	VERUS IND.	H-800	4 ea
FS-C	FLOW SWITCH (STANDARD FLOW RATE - SPDT)	JOHNSON CONTROLS	F61KB-11	3 ea
H-A	ALARM HORN 24VAC	FEDERAL/DELTA	350024-30	1 ea
IAQ-AB	CO SPACE SENSOR 0-200 PPM 4-20MA	R.E. TECH	WCO-1B	1 ea
OAC-A	OA TEMPERATURE/HUMIDITY COMBO SENSOR	BAPI	ALC/10K-2-H220-O	1 ea
REL-BC	PILOT RELAY 24 VAC DPDT W/ LED	OMRON	LY2N-24V	4 ea

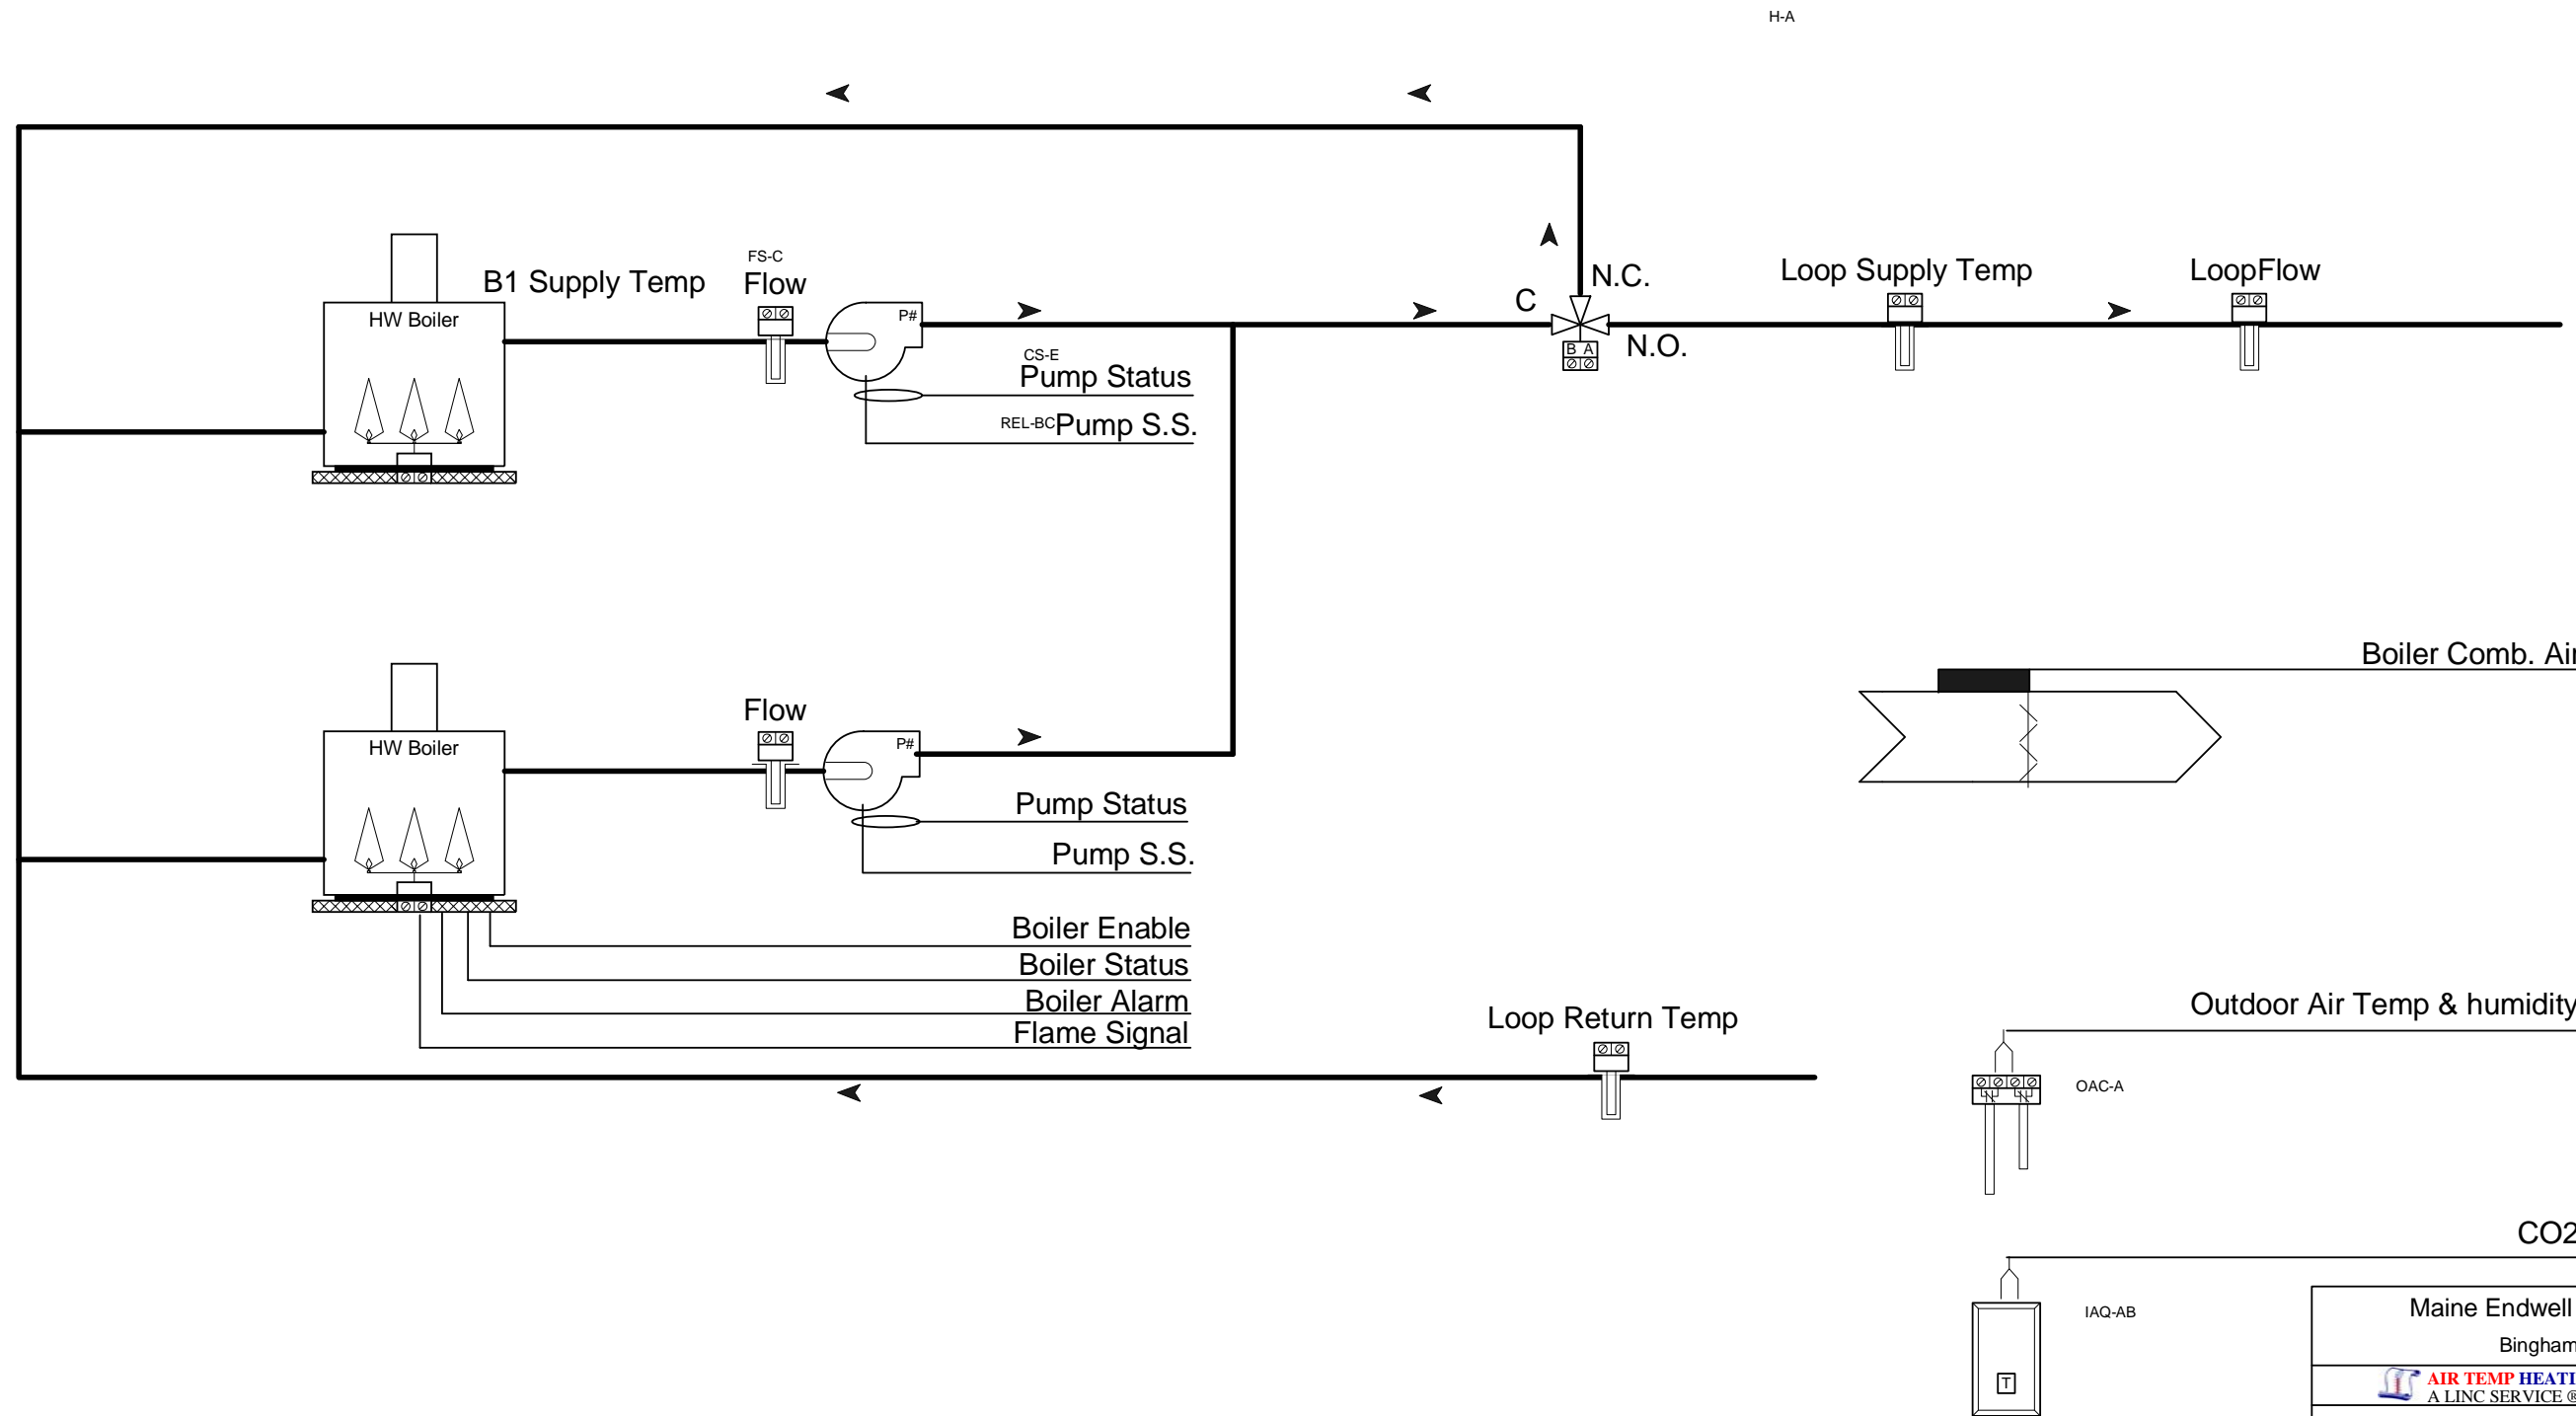



**Maine Endwell Middle School 2011**  
 Binghamton , New York  
**AIR TEMP HEATING & AIR CONDITIONING, INC.**  
 A LINC SERVICE @ CONTRACTOR  
**Boilers**

REV: 1	Submittal	9/29/2008	JOB NO: P7619
<b>AUTOMATED LOGIC</b> CORPORATION			CHECK BY: RSL
			DSCODE: 07112.00

6 of 37



# Boilers2

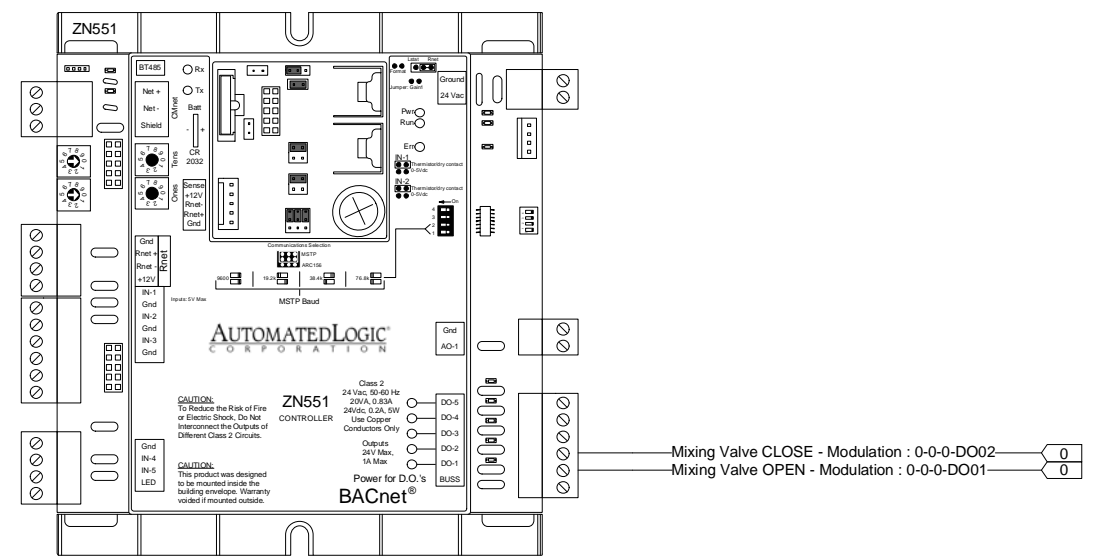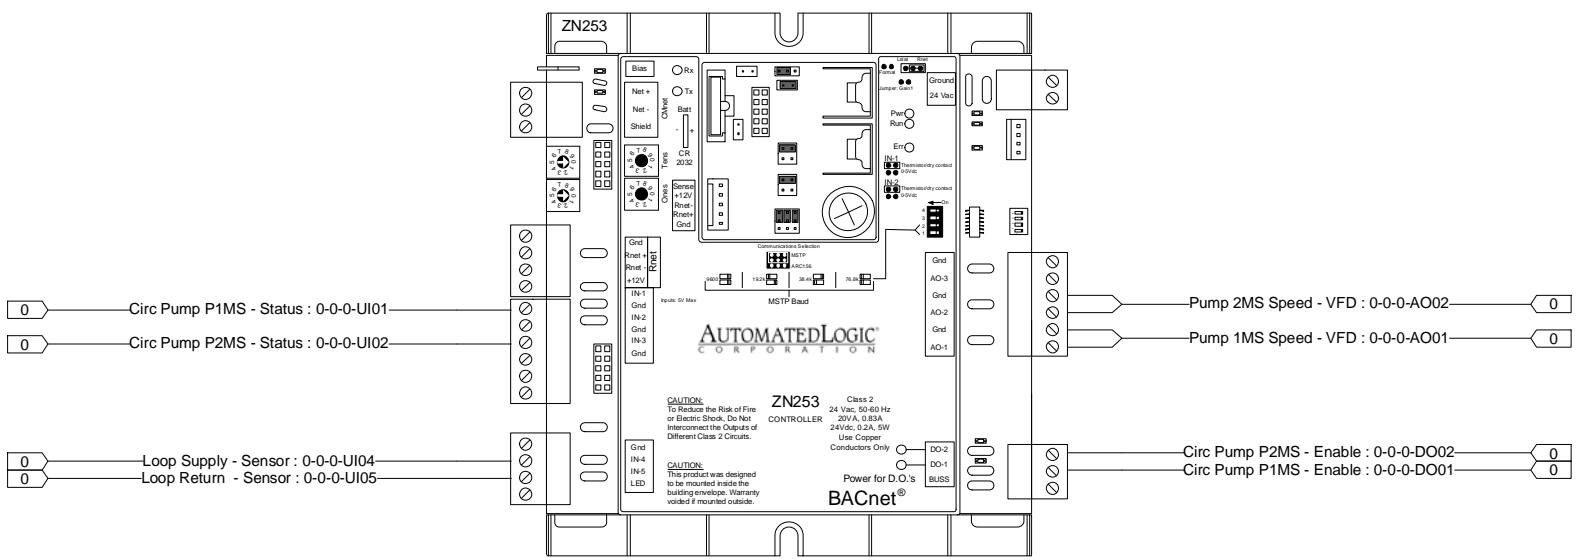Bill of Materials				
DID	DESCRIPTION	MANUFACTURER	PART NUMBER	QTY
ZN253	ZN253	AUTOMATED LOGIC	ZN253	1 ea
ZN551	ZN551	AUTOMATED LOGIC	ZN551	1 ea



**Boilers to be controlled by factory Aerco Boiler Panel C-MORE PANEL-MODBUS**

**Boiler Controls to be integrated to Automated Logic Via EQPRTL MODBUS to BACnet**

Maine Endwell Middle School 2011 Binghamton , New York			
 <b>AIR TEMP HEATING &amp; AIR CONDITIONING, INC.</b> A LINC SERVICE @ CONTRACTOR			
Boilers2			
REV: 1	Submittal	9/29/2008	JOB NO: P7619
			CHECK BY: RSL
			DSCODE: 07112.00
			7 of 37

# Boilers3

## Boiler Plant SEQUENCE

### A. General

1. All controls shall be field mounted

### B. Boiler Control

1. The Boilers shall be controlled by the boiler panel to maintain supply header temperature as reset by outdoor air temperature.
2. System shall be enabled when outdoor air temp is below 60 deg. F
3. Provide enable disable and status interface with B.A.S.

### C. Boiler reset controls

1. The boilers shall operate on a reset hot water schedule with the temperature of the hot water supply being reset inversely with outdoor air temperature.

Outdoor Air	Hot Water
60 Deg. F.	140 Deg. F.
0 Deg. F.	190 Deg. F.

### D. Boiler Emergency Shutdown.

1. When emergency shutdown switches are broken boiler shall be de energized.

### E. Boiler Room pumps

1. Boiler pump P1MS and P2MS shall be controlled by boiler control panel. Boiler pumps shall operate on Lead/lag operation. Lead pump operation shall switch weekly or as determined by owner. Pumps shall operate in a fail safe back up mode. Pump shut down shall run on outdoor air temperature, set 5 deg. F. above boiler enable S.P.

### F. Combustion Air Dampers



1. When any boiler or hot water heater is energized, the associated outdoor air damper shall open.

### G. Alarms

1. Should any pump fail, or standby pump be energized, due to failure of the lead pump, an alarm shall sound at the boiler panel.
2. Should any alarm condition occur at the boiler panel, an alarm shall be sent to the B.A.S. System.
3. Should any pump fail to run, or flow not be sensed when any terminal heating unit is an alarm shall sound an all terminal heating equipment shall be disabled.
4. Should carbon monoxide concentrations exceed 100PPM the CO monitor shall sound an alarm and alarm shall be sent to B.A.S.

**Boilers to be controlled by  
factory Aerco Boiler Panel  
C-MORE PANEL-MODBUS**

**Boiler Controls to be integrated to  
Automated Logic Via EQPRTL  
MODBUS to BACnet**

Maine Endwell Middle School 2011 Binghamton , New York			
 <b>AIR TEMP HEATING &amp; AIR CONDITIONING, INC.</b> A LINC SERVICE ® CONTRACTOR			
Boilers3			
REV: 1	Submittal	9/29/2008	JOB NO: P7619
			CHECK BY: RSL
			DSCODE: 07112.00
			8 of 37



# AHU 1MS

Serves Main Offices  
Located in Mechanical Room

Outdoor Air Damper

Redundant Outdoor Air Damper

Return Air Damper

Status

Freeze to Fan Control Circuit

Fan Start Stop  
H.O.A.

Supply Air Temp.


Cooling

Heating

Mixed Air temp

## Bill of Materials

DID	DESCRIPTION	MANUFACTURER	PART NUMBER	QTY
CS-E	CURRENT SWITCH .5-200 AMP SOLID CORE GO/NO GO	VERUS IND.	H-800	1 ea
DA-AB	SR OPEN/CLOSE 133 IN-LB 120V	BELIMO	AF120 ALC	1 ea
DA-B	SR PROPORTIONAL 133 IN-LB 2-10VDC	BELIMO	AF24-SR ALC	1 ea
DTS-A	DUCT 10K THERMISTOR PROBE 12 IN.	BAPI	ALC/10K-2-D-12	1 ea
DTS-B	DUCT 10K THERMISTOR AVERAGING 12 FT.	BAPI	ALC/10K-2-A-12	1 ea
E-A	CIRCLE AW NEMA 1 20X20X6	CIRCLE AW	20206-1	1 ea
FS-D	TEMP LOW LIMIT MAN. RESET DDPDT	LANDIS STEAFA	1341504	1 ea
LSPLUS	LOGISTAT 10K ROOM SENSOR W/ SETP ADJ, TLO, COMM	BAPI	LSPLUS	1 ea
REL-BC	PILOT RELAY 24 VAC DDPDT W/ LED	OMRON	LY2N-24V	3 ea
SE6104a	SE6104A	AUTOMATED LOGIC	SE6104A	1 ea
TR-AG	TRANSFORMER, 120/24VAC 150VA W/CCT BREAKER	CORE COMPONENTS	LE-124	1 ea

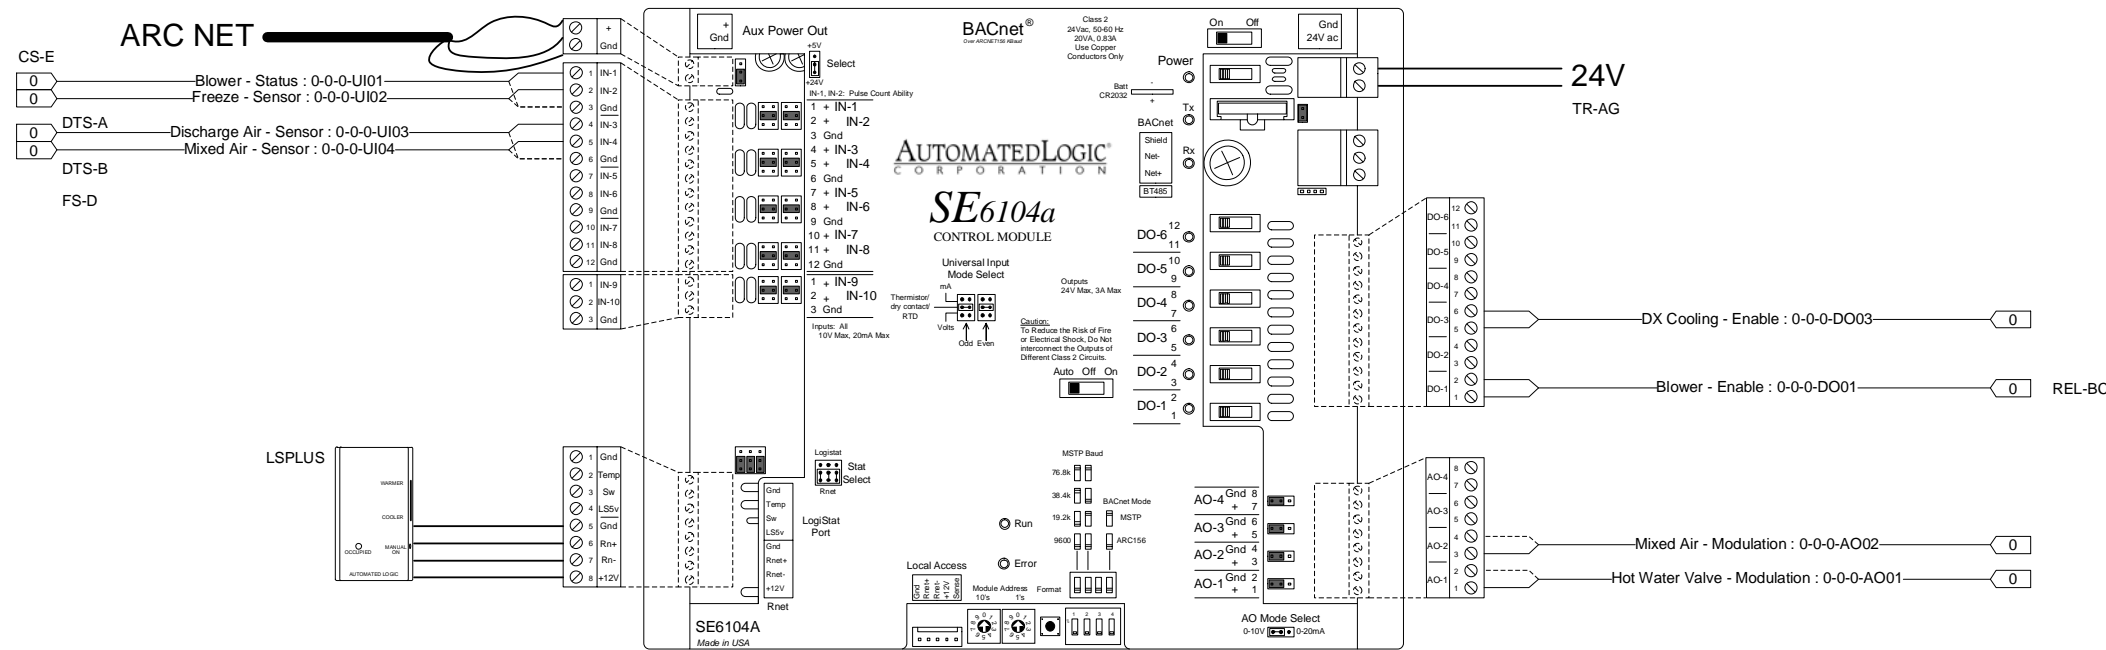

Maine Endwell Middle School 2011

Binghamton, New York

**AIR TEMP HEATING & AIR CONDITIONING, INC.**  
A LINC SERVICE @ CONTRACTOR

AHU 1MS

REV: 1	Submittal	9/29/2008	JOB NO: P7619
--------	-----------	-----------	---------------

<b>AUTOMATED LOGIC</b> CORPORATION	CHECK BY: RSL
	DSCODE: 07112.00

# AHU 1MS Sequence

## AHU 1MS Sequence

### A. General

1. Unit shall be indexed to occupied and unoccupied by B.A.S.
2. A 5 degrees dead band shall be maintained between heating and mechanical cooling space temperature set points.
3. Redundant outdoor air damper.

### B. Occupied Heating Cycle:

1. Supply fan shall run continuously and redundant outdoor air damper opens 100%
2. Outdoor air damper shall position to its scheduled minimum position with return air damper positioning correspondingly. Outdoor air is never positioned below its minimum scheduled outdoor air position.
3. Space sensor shall modulate hot water valve to maintain occupied cycle set point. Outdoor and return air dampers shall modulate to reduce overheating.

### C. Unoccupied heating Cycle:

1. The outdoor air damper shall remain fully closed, return air damper fully open with control valve modulating in sequence with supply fan to maintain unoccupied set point.
2. redundant outdoor air damper shall be closed.

### D. Warm Up Cycle:



1. The unit shall perform an optimized warm up prior to the start of the occupied mode.
2. During the warm up cycle the outdoor air damper shall remain closed., the H.W. valve shall be 100% open with 100% return air until occupied S.P. is obtained.
3. Redundant outdoor air damper shall remain closed.

### C. Occupied Cycle Cooling:

1. Supply fan shall run continuously. Redundant outdoor air damper shall be open.
2. Outdoor air damper shall position to its minimum with return air damper positioning correspondingly. Outdoor air damper is never positioned below minimum position.
3. Space sensor shall cycle condensing unit to maintain occupied cycle set point.
4. Discharge air Low limit shall be disabled.

### D. Unoccupied Cycle Cooling:

1. The outdoor air damper shall remain fully closed, return air damper fully opened with condensing unit and supply fan cycling to maintain unoccupied S.P.
2. Redundant outdoor air damper shall remain closed..

Maine Endwell Middle School 2011 Binghamton , New York			
 AIR TEMP HEATING & AIR CONDITIONING, INC. A LINC SERVICE ® CONTRACTOR			
AHU 1MS Sequence			
REV: 1	Submittal	9/29/2008	JOB NO: P7619
			CHECK BY: RSL
			DSCODE: 07112.00
			10 of 37

## AHU 1MS Sequence2

### E. Cool Down Cycle:

1. The unit shall perform an optimized cool down prior to the start of the occupied mode.
2. During the cool down cycle the outdoor air damper shall remain closed. The unit shall recirculate 100% return air in sequence with the condensing unit to obtain occupied S.P.
3. Redundant outdoor air damper shall remain closed.

### F. Exhaust Fan Interlock:



1. Where called for, whenever the interlocked exhaust fan is energized, the air handling unit shall be returned to occupied cycle, with outdoor air damper 100% open and return air damper closed.

### G. Economizer:


1. Unit shall utilize 100% outdoor air based on single building enthalpy sensor whenever possible, for free cooling.

### H. Safeties:

1. Discharge air sensor shall indicate an alarm when high temperature discharge air is sensed through the coil ( 130 Deg. F.)
2. Low temperature limit shall de energize unit when low coil temperature is sensed ( 37 Deg. F.)
3. Fan shutdown shall be provided by the electrical contractor through the B.A.S.
4. Discharge air sensor shall assume control of dampers as required ( outdoor air damper closed return air damper open control valve to 100%) to maintain minimum discharge air temperature of 55 Deg. F.

Maine Endwell Middle School 2011 Binghamton , New York			
 <b>AIR TEMP HEATING &amp; AIR CONDITIONING, INC.</b> A LINC SERVICE ® CONTRACTOR			
AHU 1MS Sequence2			
REV: 1	Submittal	9/29/2008	JOB NO: P7619
			CHECK BY: RSL
			DSCODE: 07112.00
			11 of 37

# HRU

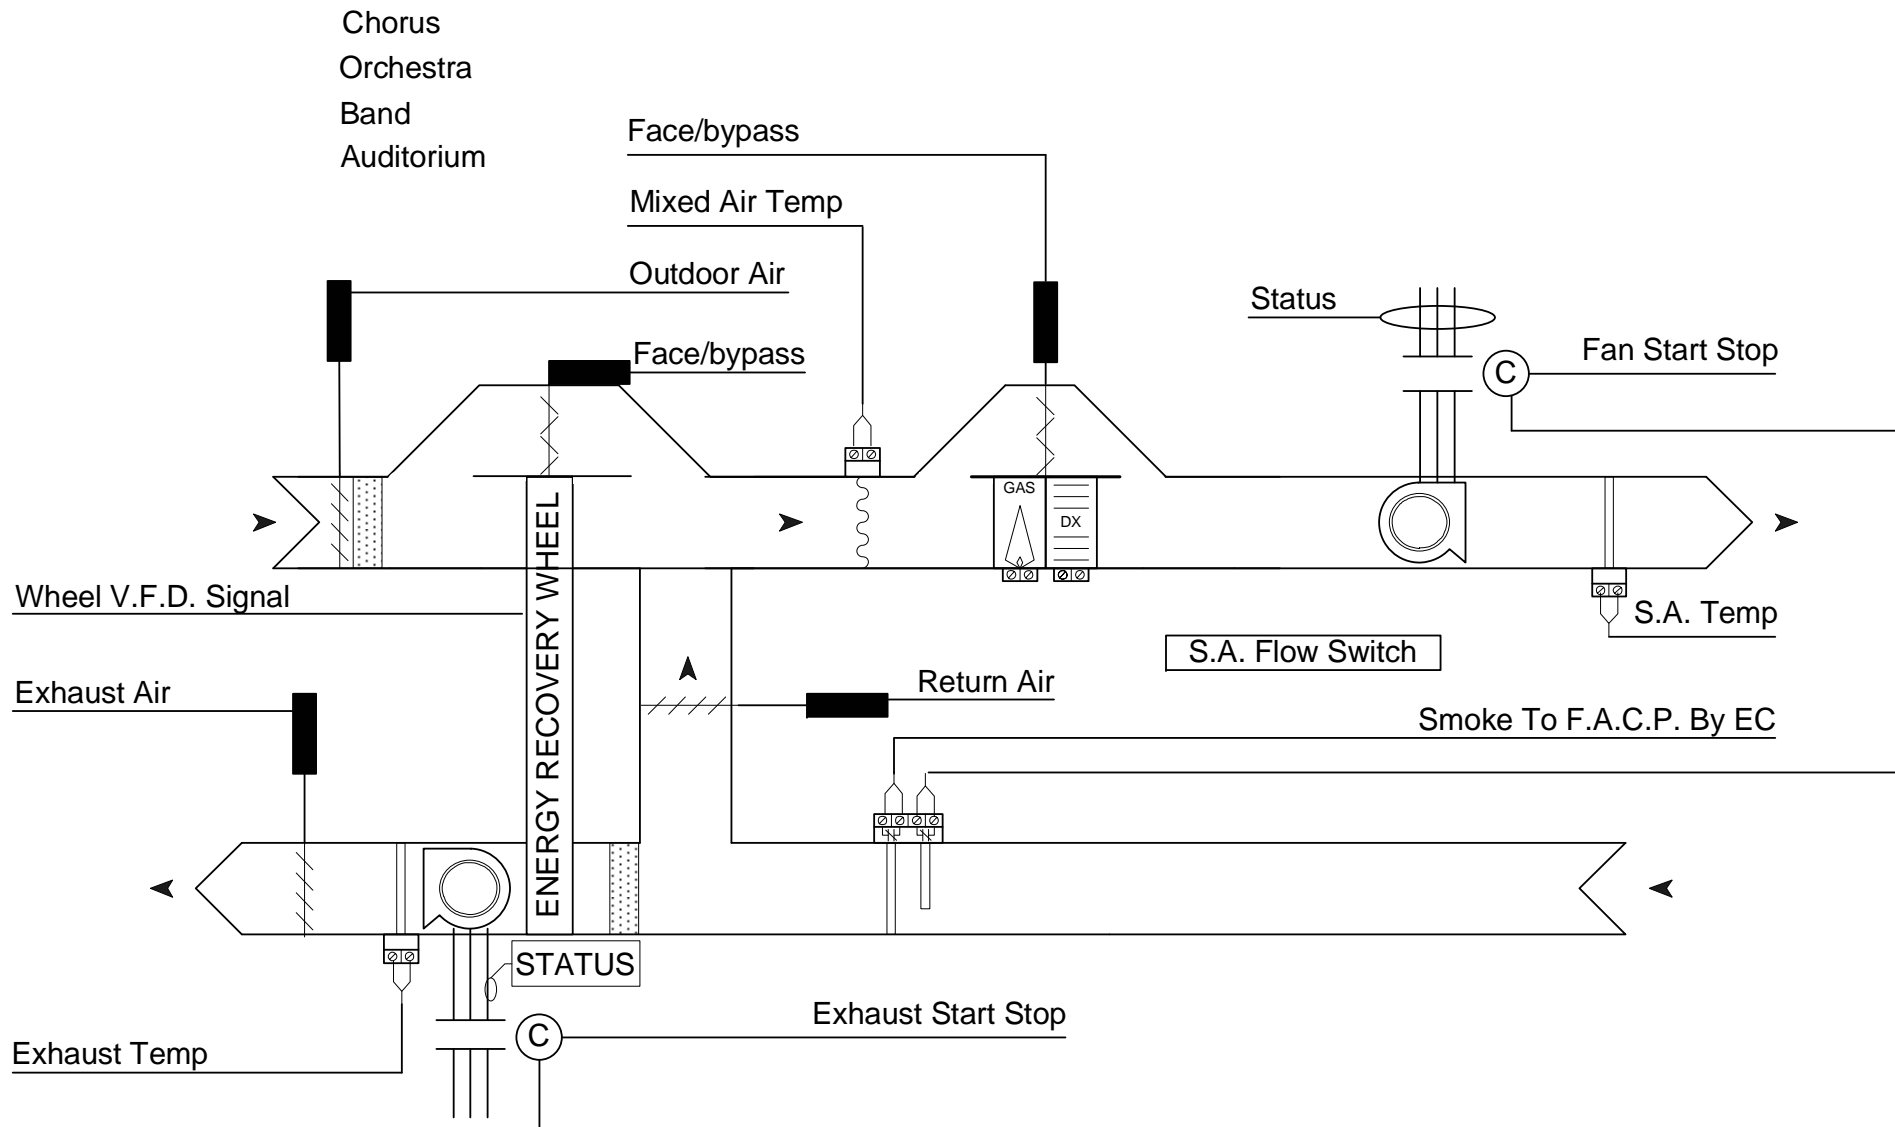

Wheel V.F.D. Signal

Exhaust Air

Exhaust Temp

Face/bypass

Mixed Air Temp

Outdoor Air

Face/bypass

Status

Fan Start Stop

Return Air

S.A. Flow Switch

S.A. Temp

Smoke To F.A.C.P. By EC

STATUS

Exhaust Start Stop

- \_\_\_\_\_ SUPPLY FAN
- \_\_\_\_\_ RETURN FAN
- \_\_\_\_\_ HEAT 1
- \_\_\_\_\_ HEAT 2
- \_\_\_\_\_ HEAT MOD
- \_\_\_\_\_ COOL 1
- \_\_\_\_\_ COOL 2
- \_\_\_\_\_ ECON

## Bill of Materials

DID	DESCRIPTION	MANUFACTURER	PART NUMBER	QTY
EQ-PRTL	EQUIPMENT PORTAL	AUTOMATED LOGIC	EQ-PRTL	1 ea

### AHU Control

- A. General:**
1. Provided field mounted controls.
  2. Index unit to occupied and unoccupied cycles from BMS.
- B. Safeties:**
1. Stop fans, shut hot water valve for high temperature, shut OA damper, open RA damper, and generate alarm at BMS when any of the following occurs:
    - a. Discharge air temperature is above 130°F.
    - b. Discharge air temperature is below 40°F.
    - c. Freezestat is less than 36°F.
    - d. Smoke detector senses smoke.
    - e. Fire alarm from F.A.C.P. by EC
  2. Smoke detectors are furnished by EC, mounted and wired to alarm panel and starter by EC.
- C. Occupied Cycle:**
1. Run supply and exhaust fan continuously.
  2. Open unit E.A.100 Percent, and modulate O.A. to Minimum position
  3. Modulate face/bypass damper at gas furnace to maintain 90 deg. Supply air in heat mode.
  5. Cycle DX cooling to maintain 55 deg. Supply air during cooling mode
  6. heat recovery face/bypass damper shall modulate to maintain a minimum of 35 deg. Leaving the heat exchanger to prevent frost
- D. Economizer Position:**
1. Unit shall utilize 100% outside air for cooling.
  2. Economizer shall initiate from the units enthalpy sensor.
  3. O.A. damper shall open to 100%
  4. Heat wheel face/bypass damper shall open to full bypass.
  5. Gas burner/DX face/bypass damper shall go to full bypass.
  6. Return air damper shall modulate closed.
- E. Un-Occupied Cycle:**
1. Stop supply fan
  2. Shut outside air and open exhaust air dampers.
  3. Open return air damper to 100%
  4. Supply fan and gas furnace shall maintain space set point.
- F. Warm-Up Cycle:**
1. Supply fan shall energize
  2. Gas furnace shall energize.
  3. HRU shall recirculate 100% return air until space reaches set point.

Maine Endwell Middle School 2011

Binghamton, New York

**AIR TEMP HEATING & AIR CONDITIONING, INC.**  
A LINC SERVICE @ CONTRACTOR

HRU

REV: 1	Submittal	9/29/2008	JOB NO: P7619
--------	-----------	-----------	---------------

**AUTOMATED LOGIC**  
CORPORATION

CHECK BY: RSL



DSCODE: 07112.00

# RTU


RTU 1MS Serving 2<sup>nd</sup> floor music lessons

RTU 2MS Serving 2<sup>nd</sup> floor area E Main Entrance

Bill of Materials				
DID	DESCRIPTION	MANUFACTURER	PART NUMBER	QTY
CS-E	CURRENT SWITCH .5-200 AMP SOLID CORE GO/NO GO	VERUS IND.	H-800	4 ea
DA-AC	NSR PROPORTIONAL 35 IN-LB 24 V	BELIMO	LM24-SR ALC	2 ea
DTS-A	DUCT 10K THERMISTOR PROBE 12 IN.	BAPI	ALC/10K-2-D-12	2 ea
DTS-B	DUCT 10K THERMISTOR AVERAGING 12 FT.	BAPI	ALC/10K-2-A-12	2 ea
LSPLUS	LOGISTAT 10K ROOM SENSOR W/ SETP ADJ, TLO, COMM	BAPI	LSPLUS	2 ea

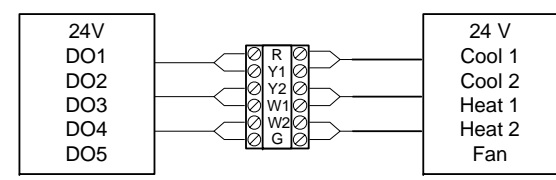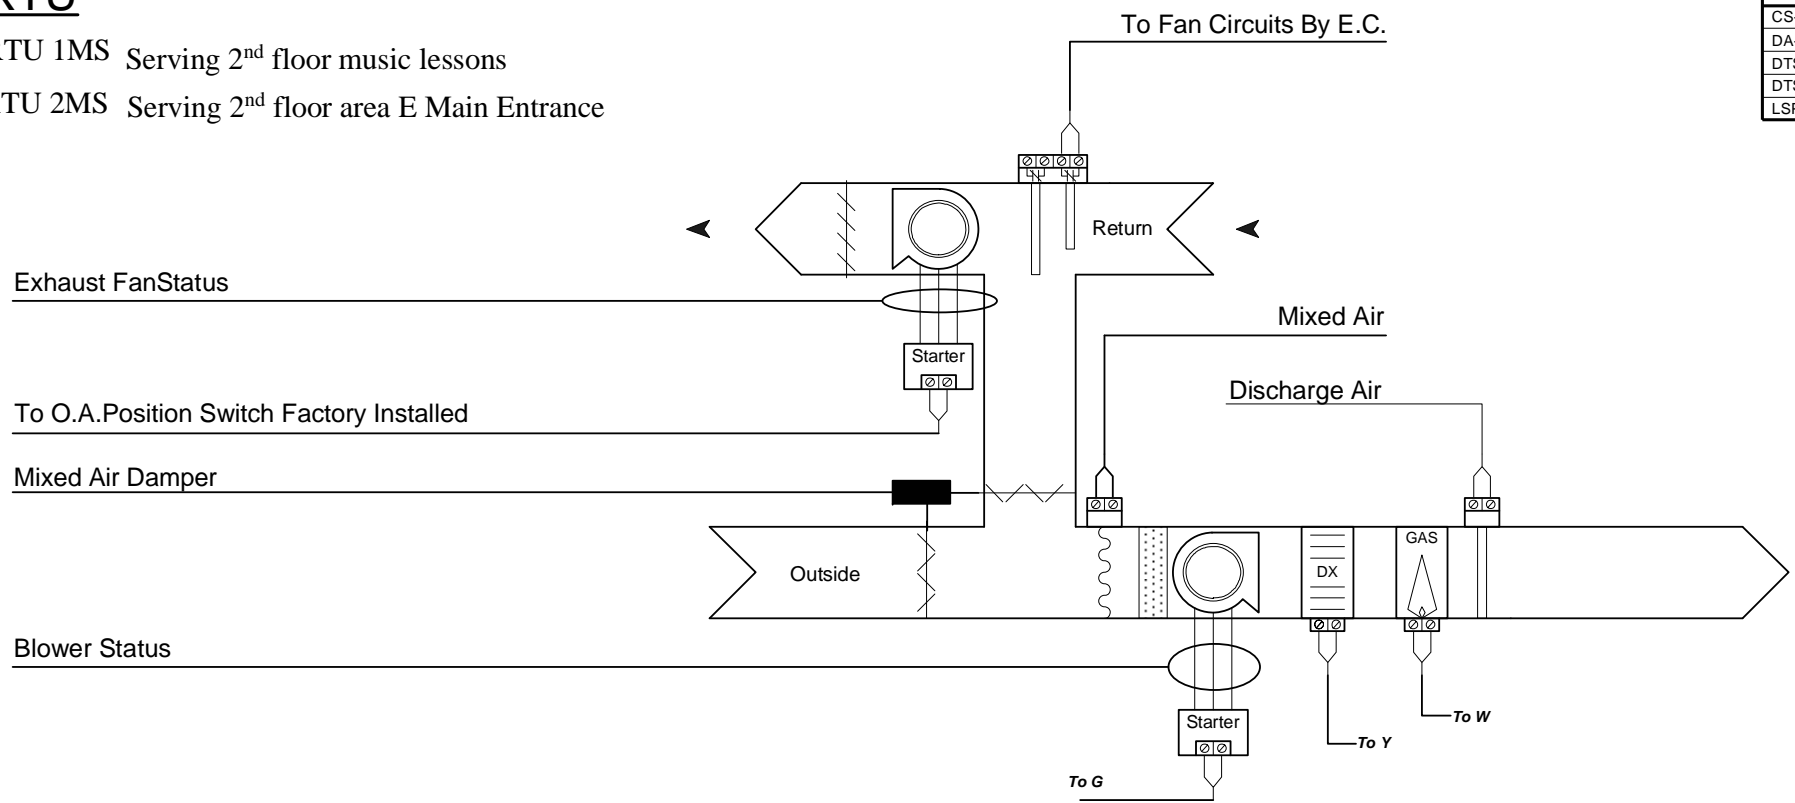

All Field mounted Automated Logic Controllers will be mounted indoors

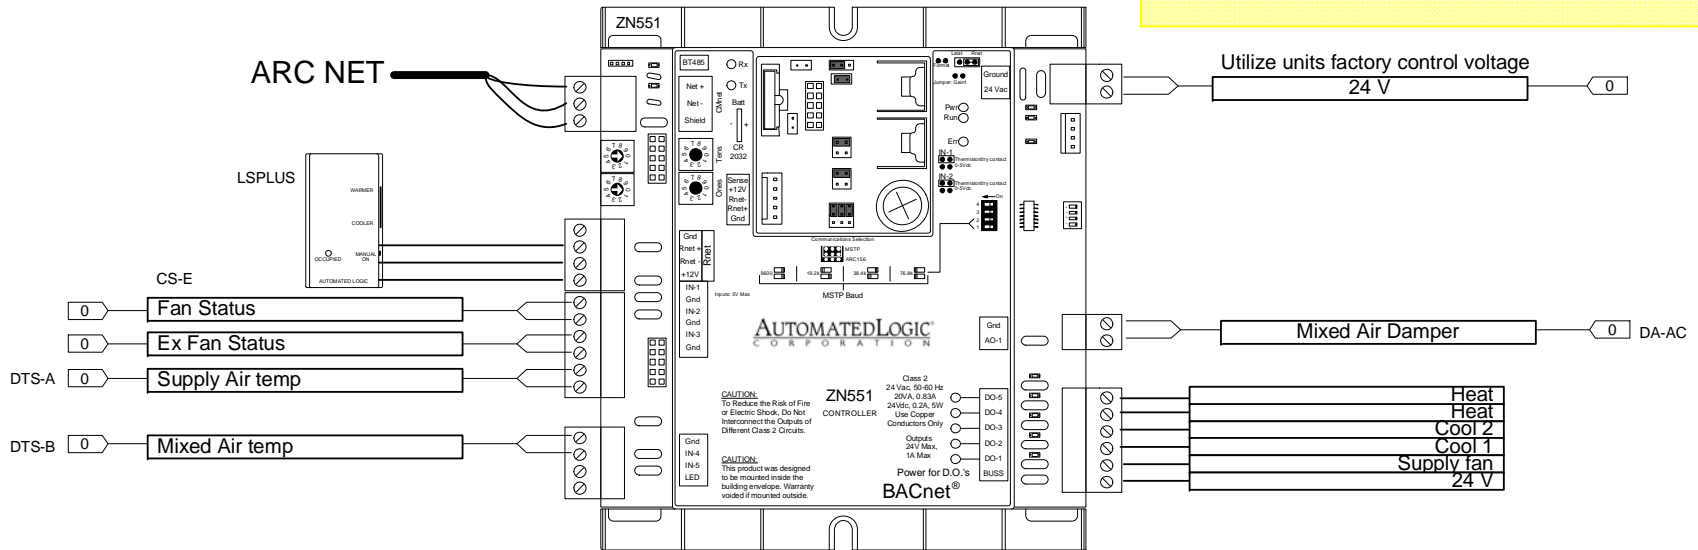

Maine Endwell Middle School 2011  
Binghamton , New York

**AIR TEMP HEATING & AIR CONDITIONING, INC.**  
A LINC SERVICE @ CONTRACTOR

RTU

REV: 1	Submittal	9/29/2008	JOB NO: P7619
<b>AUTOMATEDLOGIC</b> CORPORATION			CHECK BY: RSL
			DSCODE: 07112.00

13 of 37

# RTU Sequence

## A. General

1. Unit shall be indexed to occupied and unoccupied by B.A.S.
2. A 5 degrees dead band shall be maintained between heating and mechanical cooling space temperature set points.

## B. Occupied Heating Cycle:

1. Supply fan shall run continuously and redundant outdoor air damper opens 100%
2. Outdoor air damper shall position to its scheduled minimum position with return air damper positioning correspondingly. Outdoor air is never positioned below its minimum scheduled outdoor air position.
3. Space sensor cycle gas burners to maintain occupied cycle set point. Outdoor and return air dampers shall modulate to reduce overheating.

## C. Unoccupied heating Cycle:

1. The outdoor air damper shall remain fully closed, return air damper fully open with burners modulating in sequence with supply fan to maintain unoccupied set point.

## D. Warm Up Cycle:



1. The unit shall perform an optimized warm up prior to the start of the occupied mode.
2. During the warm up cycle the outdoor air damper shall remain closed., the burners shall run with 100% return air until occupied S.P. is obtained.

## C. Occupied Cycle Cooling:

1. Supply fan shall run continuously.
2. Outdoor air damper shall position to its minimum with return air damper positioning correspondingly. Outdoor air damper is never positioned below minimum position.
3. Space sensor shall cycle condensing unit to maintain occupied cycle set point.
4. Discharge air Low limit shall be disabled.

## D. Unoccupied Cycle Cooling:

1. The outdoor air damper shall remain fully closed, return air damper fully opened with condensing unit and supply fan cycling to maintain unoccupied S.P.

Maine Endwell Middle School 2011 Binghamton , New York			
 <b>AIR TEMP HEATING &amp; AIR CONDITIONING, INC.</b> A LINC SERVICE ® CONTRACTOR			
RTU Sequence			
REV: 1	Submittal	9/29/2008	JOB NO: P7619
			CHECK BY: RSL
			DSCODE: 07112.00
			14 of 37

## RTU Sequence 2

### E. Cool Down Cycle:

1. The unit shall perform an optimized cool down prior to the start of the occupied mode.
2. During the cool down cycle the outdoor air damper shall remain closed. The unit shall recirculate 100% return air in sequence with the condensing unit to obtain occupied S.P.

### F. Exhaust Fan Interlock:



1. Where called for, whenever the interlocked exhaust fan is energized, the air handling unit shall be returned to occupied cycle, with outdoor air damper 100% open and return air damper closed.

### G. Economizer:

1. Unit shall utilize 100% outdoor air based on single building enthalpy sensor whenever possible, for free cooling.

### H. Safeties:


1. Discharge air sensor shall indicate an alarm when high temperature discharge air is sensed through the coil ( 130 Deg. F.)
2. Low temperature limit shall de energize unit when low coil temperature is sensed ( 37 Deg. F.)
3. Fan shutdown shall be provided by the electrical contractor through the B.A.S.
4. Discharge air sensor shall assume control of dampers as required ( outdoor air damper closed return air damper open control valve to 100%) to maintain minimum discharge air temperature of 55 Deg. F.

Maine Endwell Middle School 2011 Binghamton , New York			
 <b>AIR TEMP HEATING &amp; AIR CONDITIONING, INC.</b> A LINC SERVICE ® CONTRACTOR			
RTU Sequence 2			
REV: 1	Submittal	9/29/2008	JOB NO: P7619
			CHECK BY: RSL
			DSCODE: 07112.00
			15 of 37

# RTU Existing

Typical for 6  
Serving Cafeteria East/West  
Gymnasium 4 Units

Bill of Materials				
DID	DESCRIPTION	MANUFACTURER	PART NUMBER	QTY
CS-E	CURRENT SWITCH .5-200 AMP SOLID CORE GO/NO GO	VERUS IND.	H-800	16 ea
DTS-A	DUCT 10K THERMISTOR PROBE 12 IN.	BAPI	ALC/10K-2-D-12	8 ea
LSPLUS	LOGISTAT 10K ROOM SENSOR W/ SETP ADJ. TLO, COMM	BAPI	LSPLUS	8 ea
ZN253	ZN253	AUTOMATED LOGIC	ZN253	8 ea

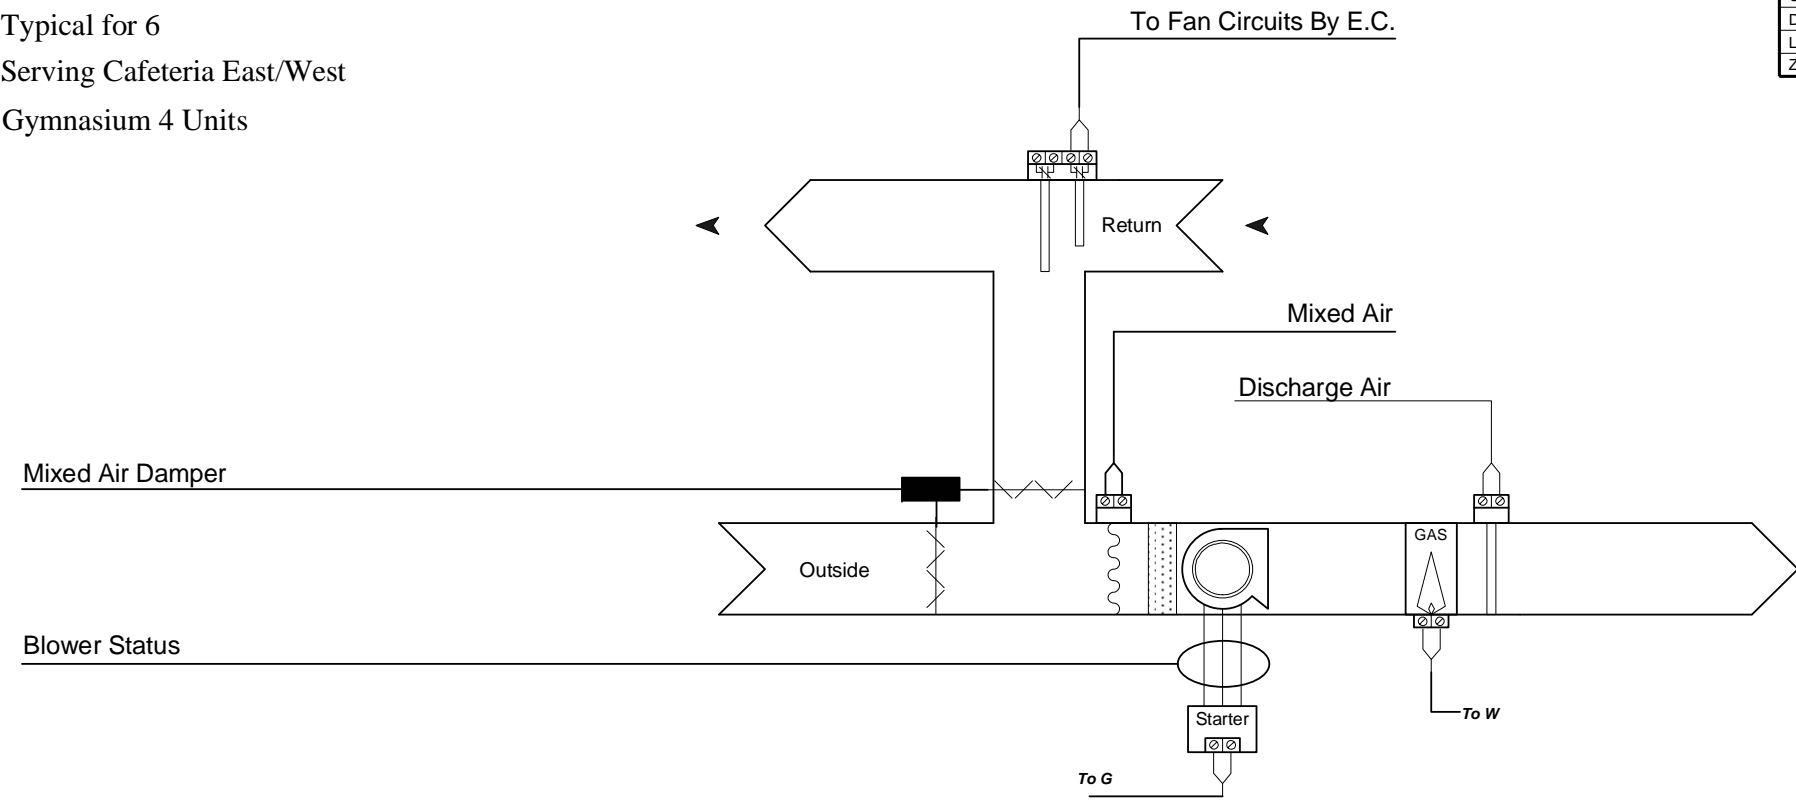

### A. General

1. Unit shall be indexed to occupied and unoccupied by B.A.S.
2. A 5 degrees dead band shall be maintained between heating and mechanical cooling space temperature set points.

### B. Occupied Heating Cycle:

1. Supply fan shall run continuously and redundant outdoor air damper opens 100%
2. Outdoor air damper shall position to its scheduled minimum position with return air damper positioning correspondingly. Outdoor air is never positioned below its minimum scheduled outdoor air position.
3. Space sensor cycle gas burners to maintain occupied cycle set point. Outdoor and return air dampers shall modulate to reduce overheating.

### C. Unoccupied heating Cycle:

1. The outdoor air damper shall remain fully closed, return air damper fully open with burners modulating in sequence with supply fan to maintain unoccupied set point.


### D. Warm Up Cycle:

1. The unit shall perform an optimized warm up prior to the start of the occupied mode.
2. During the warm up cycle the outdoor air damper shall remain closed., the burners shall run with 100% return air until occupied S.P. is obtained.

### E. Safeties:

1. Stop fans, shut hot water valve for high temperature, shut OA damper, open RA damper, and generate alarm at BMS when any of the following occurs:
  - a. Discharge air temperature is above 130°F.
  - b. Discharge air temperature is below 40°F.
  - c. Freezestat is less than 36°F.
  - d. Smoke detector senses smoke.
  - e. Fire alarm from F.A.C.P. by EC.

All Field mounted Automated Logic Controllers will be mounted indoors

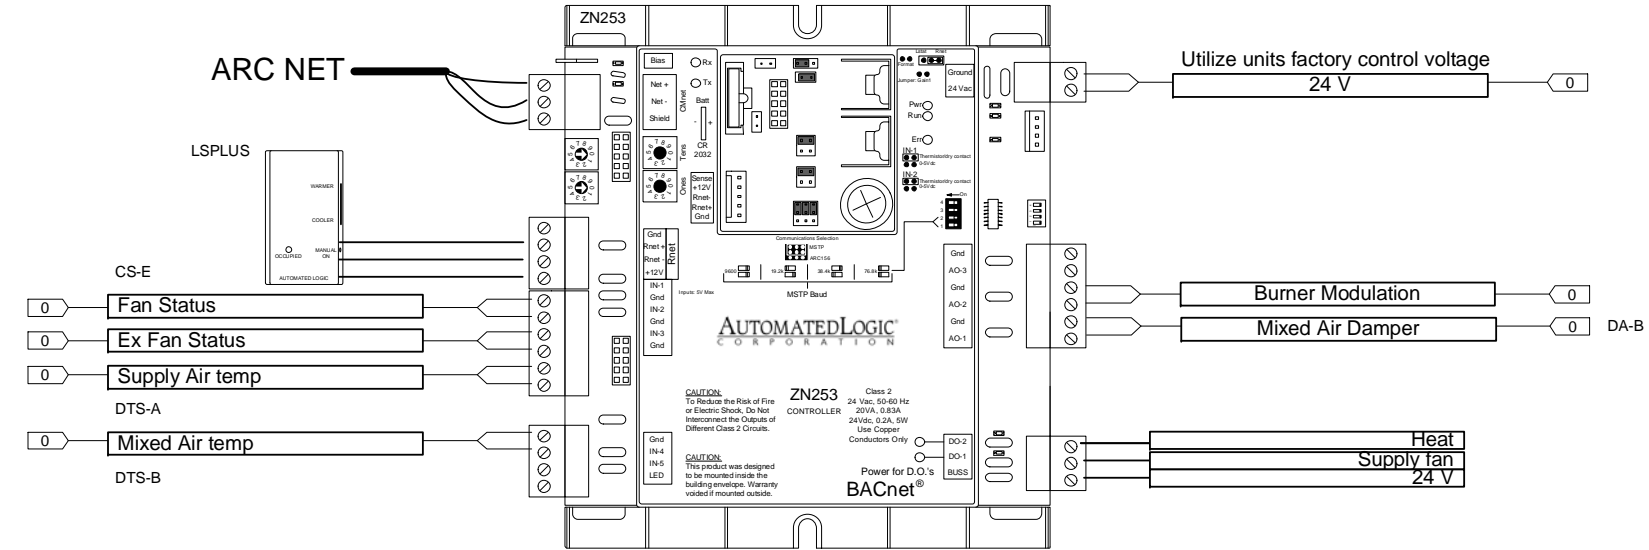

Maine Endwell Middle School 2011  
Binghamton , New York

**AIR TEMP HEATING & AIR CONDITIONING, INC.**  
A LINC SERVICE @ CONTRACTOR

RTU Existing

REV: 1	Submittal	9/29/2008	JOB NO: P7619
<b>AUTOMATED LOGIC</b> CORPORATION			CHECK BY: RSL
			DSCODE: 07112.00



16 of 37




# RTU. E. DX

2 Library Units

Bill of Materials				
DID	DESCRIPTION	MANUFACTURER	PART NUMBER	QTY
CS-E	CURRENT SWITCH .5-200 AMP SOLID CORE GO/NO GO	VERUS IND.	H-800	4 ea
DTS-A	DUCT 10K THERMISTOR PROBE 12 IN.	BAPI	ALC/10K-2-D-12	2 ea
DTS-B	DUCT 10K THERMISTOR AVERAGING 12 FT.	BAPI	ALC/10K-2-A-12	2 ea
LSPLUS	LOGISTAT 10K ROOM SENSOR W/ SETP ADJ. TLO. COMM	BAPI	LSPLUS	2 ea
ZN551	ZN551	AUTOMATED LOGIC	ZN551	2 ea

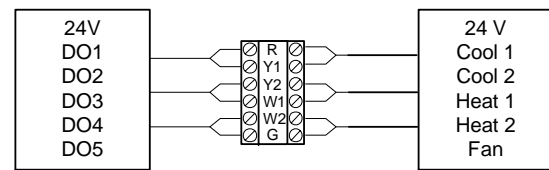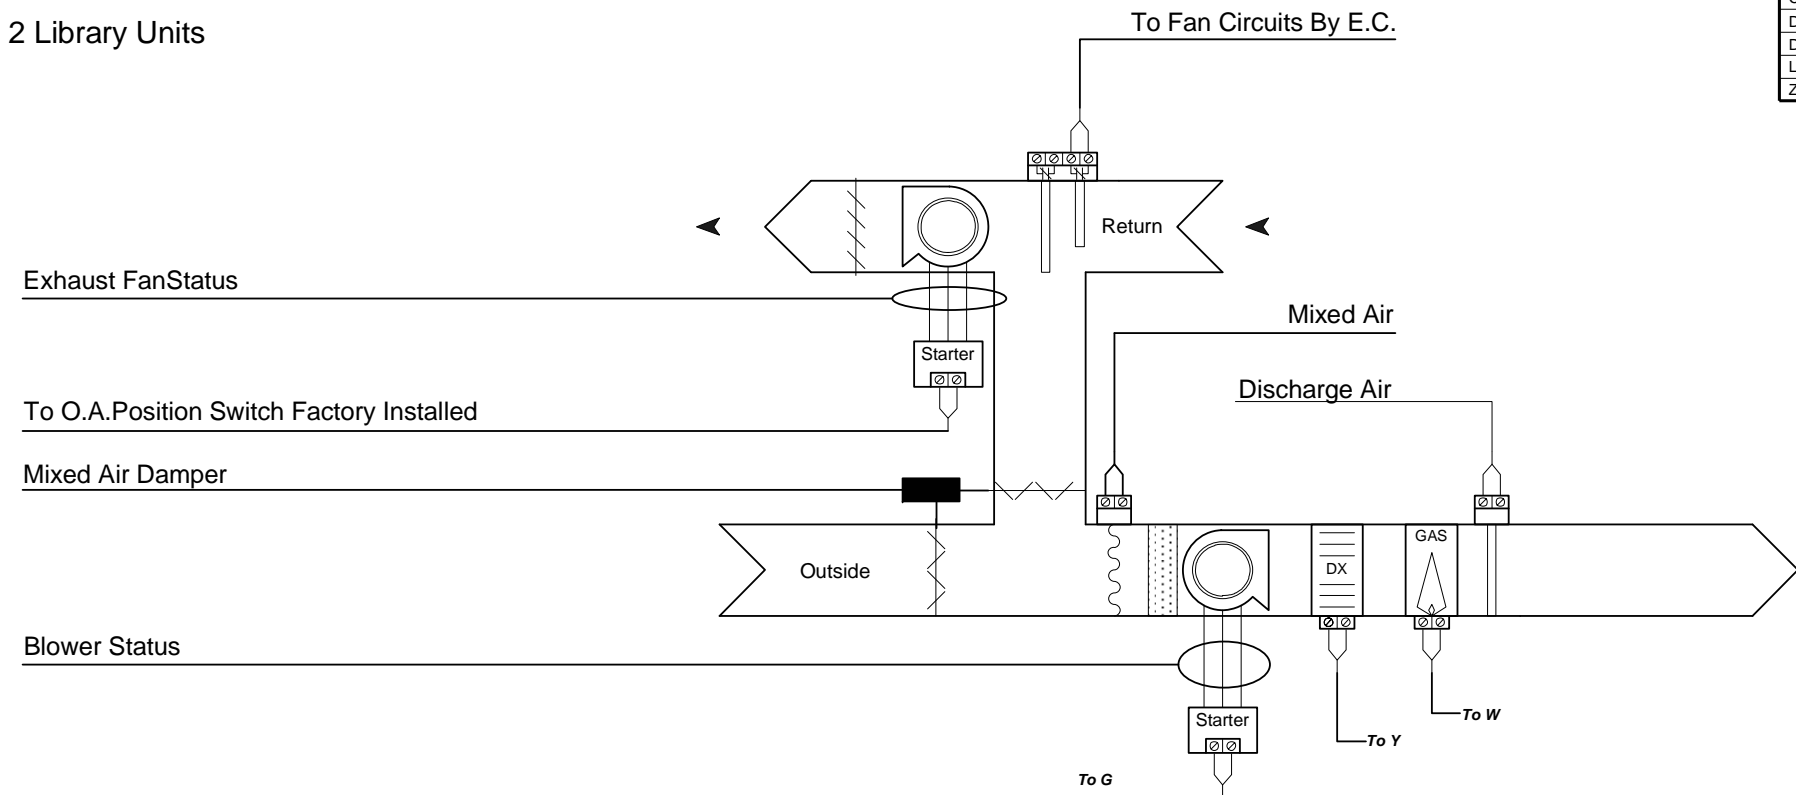

All Field mounted Automated Logic Controllers will be mounted indoors

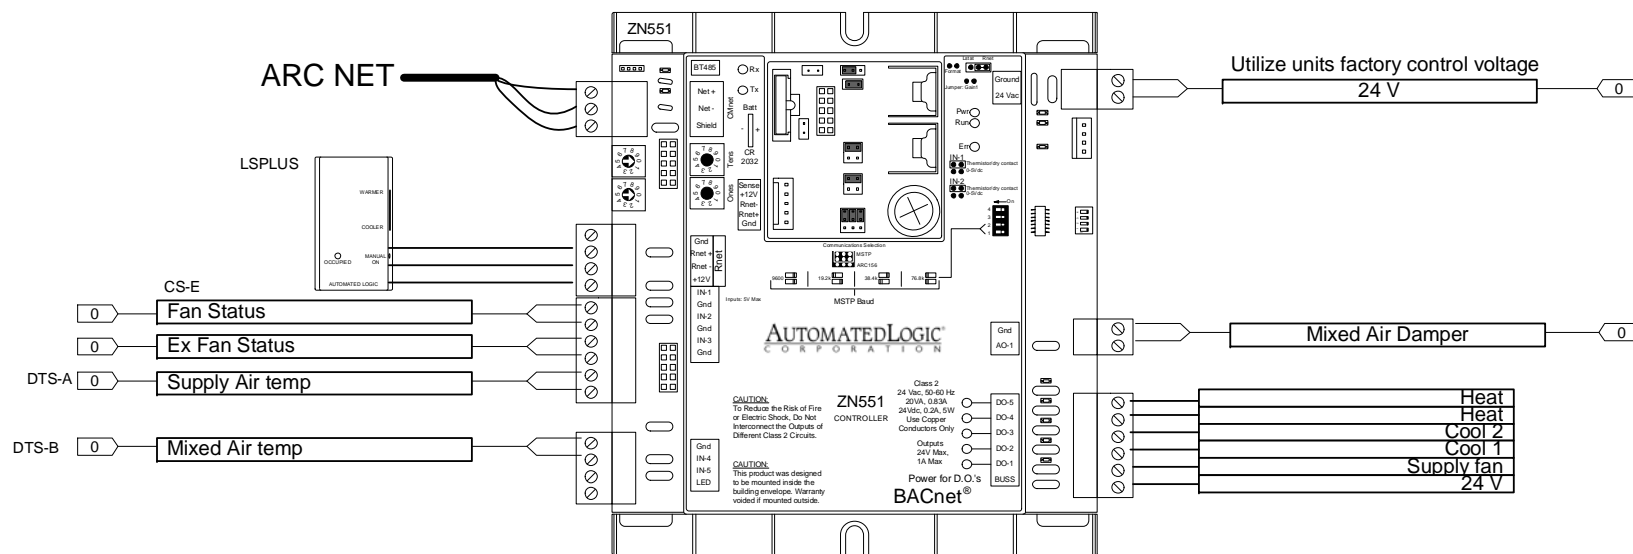

Maine Endwell Middle School 2011 Binghamton , New York			
AIR TEMP HEATING & AIR CONDITIONING, INC. A LINC SERVICE @ CONTRACTOR			
RTU. E. DX			
REV: 1	Submittal	9/29/2008	JOB NO: P7619
AUTOMATED LOGIC CORPORATION			CHECK BY: RSL DSCODE: 07112.00
			17 of 37

# RTU Existing Sequence 1

## A. General

1. Unit shall be indexed to occupied and unoccupied by B.A.S.
2. A 5 degrees dead band shall be maintained between heating and mechanical cooling space temperature set points.

## B. Occupied Heating Cycle:

1. Supply fan shall run continuously and redundant outdoor air damper opens 100%
2. Outdoor air damper shall position to its scheduled minimum position with return air damper positioning correspondingly. Outdoor air is never positioned below its minimum scheduled outdoor air position.
3. Space sensor cycle gas burners to maintain occupied cycle set point. Outdoor and return air dampers shall modulate to reduce overheating.

## C. Unoccupied heating Cycle:

1. The outdoor air damper shall remain fully closed, return air damper fully open with burners modulating in sequence with supply fan to maintain unoccupied set point.

## D. Warm Up Cycle:



1. The unit shall perform an optimized warm up prior to the start of the occupied mode.
2. During the warm up cycle the outdoor air damper shall remain closed., the burners shall run with 100% return air until occupied S.P. is obtained.

## C. Occupied Cycle Cooling:

1. Supply fan shall run continuously.
2. Outdoor air damper shall position to its minimum with return air damper positioning correspondingly. Outdoor air damper is never positioned below minimum position.
3. Space sensor shall cycle condensing unit to maintain occupied cycle set point.
4. Discharge air Low limit shall be disabled.

## D. Unoccupied Cycle Cooling:

1. The outdoor air damper shall remain fully closed, return air damper fully opened with condensing unit and supply fan cycling to maintain unoccupied S.P.

Maine Endwell Middle School 2011 Binghamton , New York			
 AIR TEMP HEATING & AIR CONDITIONING, INC. A LINC SERVICE ® CONTRACTOR			
RTU Existing Sequence 1			
REV: 1	Submittal	9/29/2008	JOB NO: P7619
			CHECK BY: RSL
			DSCODE: 07112.00
			18 of 37

## RTU Existing Sequence 2

### E. Cool Down Cycle:

1. The unit shall perform an optimized cool down prior to the start of the occupied mode.
2. During the cool down cycle the outdoor air damper shall remain closed. The unit shall recirculate 100% return air in sequence with the condensing unit to obtain occupied S.P.

### F. Exhaust Fan Interlock:



1. Where called for, whenever the interlocked exhaust fan is energized, the air handling unit shall be returned to occupied cycle, with outdoor air damper 100% open and return air damper closed.

### G. Economizer:


1. Unit shall utilize 100% outdoor air based on single building enthalpy sensor whenever possible, for free cooling.

### H. Safeties:



1. Discharge air sensor shall indicate an alarm when high temperature discharge air is sensed through the coil ( 130 Deg. F.)
2. Low temperature limit shall de energize unit when low coil temperature is sensed ( 37 Deg. F.)
3. Fan shutdown shall be provided by the electrical contractor through the B.A.S.
4. Discharge air sensor shall assume control of dampers as required ( outdoor air damper closed return air damper open control valve to 100%) to maintain minimum discharge air temperature of 55 Deg. F.

Maine Endwell Middle School 2011 Binghamton , New York			
 <b>AIR TEMP HEATING &amp; AIR CONDITIONING, INC.</b> A LINC SERVICE ® CONTRACTOR			
RTU Existing Sequence 2			
REV: 1	Submittal	9/29/2008	JOB NO: P7619
			CHECK BY: RSL
			DSCODE: 07112.00
			19 of 37
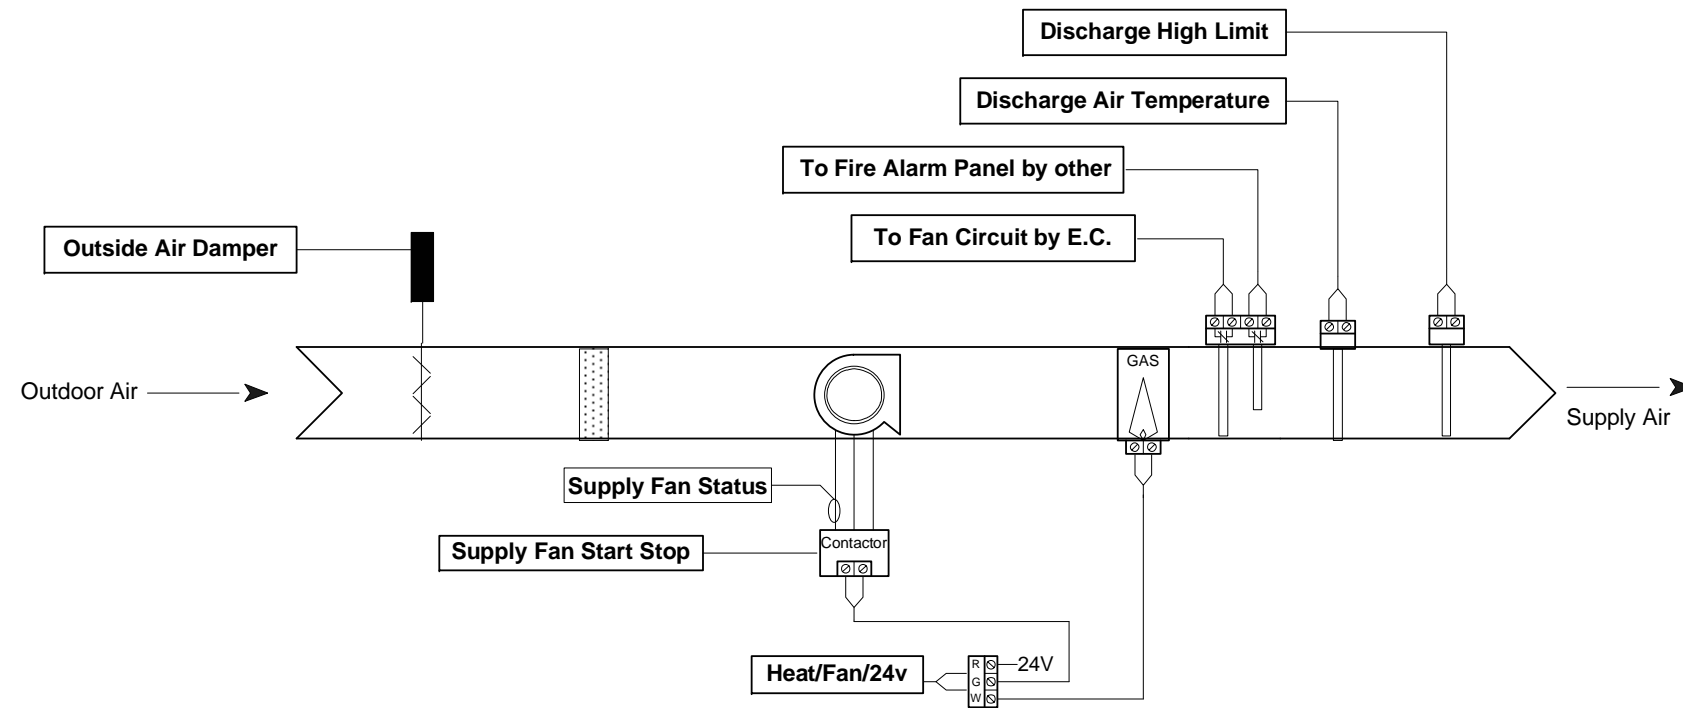
# Make Up Air





**MAU CONTROL**  
 Packaged Roof top MAU's to be provided with factory Installed controls  
**FACTORY CONTROLLED BY MELINK**

Maine Endwell Middle School 2011 Binghamton , New York			
 <b>AIR TEMP HEATING &amp; AIR CONDITIONING, INC.</b> A LINC SERVICE ® CONTRACTOR			
Make Up Air			
REV: 1	Submittal	9/29/2008	JOB NO: P7619
			CHECK BY: RSL
			DSCODE: 07112.00
			20 of 37

# Unit Ventilators

Typical For 63 New Unit Ventilators

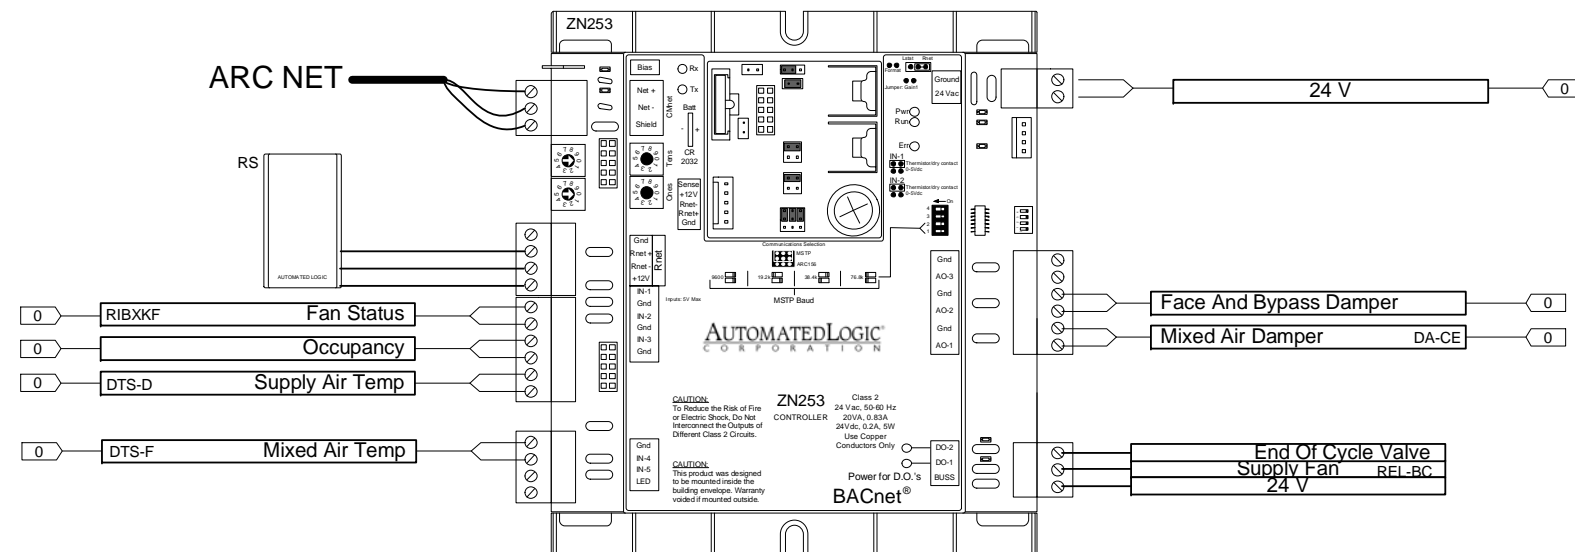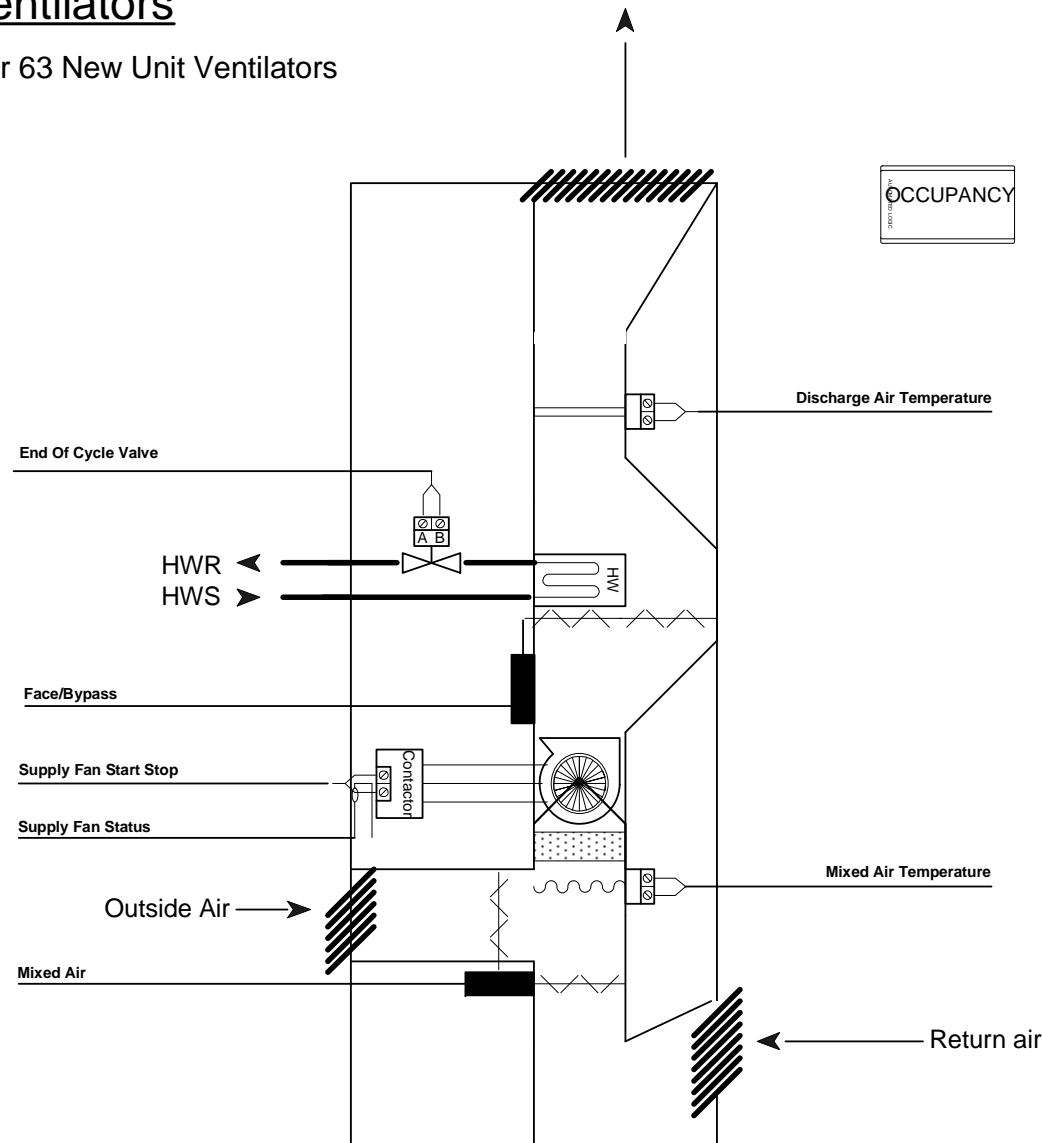

## Bill of Materials

DID	DESCRIPTION	MANUFACTURER	PART NUMBER	QTY
DA-CE	SR 0-10VDC 35 IN-LB 24 V	BELIMO	LF24-SR ALC	126 ea
DTS-D	DUCT 10K THERMISTOR PROBE 8 IN.	BAPI	ALC/10K-2-D-8	63 ea
DTS-F	DUCT 10K THERMISTOR AVERAGING 8 FT.	BAPI	ALC/10K-2-A-8	63 ea
REL-BC	PILOT RELAY 24 VAC DPDT W/ LED	OMRON	LY2N-24V	63 ea
RIBXKF	.25 TO 150 CURRENT SENSOR	FUNCTIONAL DEVICES	RIBXKF	63 ea
RS	ROOM STAT	ALC	RS	63 ea
ZN253	ZN253	AUTOMATED LOGIC	ZN253	63 ea

### UV CONTROL

#### A. GENERAL:

1. Provide field mounted controls.
2. Index unit to occupied and unoccupied cycles from BMS.
3. End of cycle valve is normally open and shall close when unit begins economizer mode.

#### B. SAFETIES:

1. Stop fan shut outside air damper open return air damper, open face damper, and generate and alarm at BMS when any of the following occur.

- a. Discharge air temp is above 130 degrees F.
- b. Discharge air temp is below 40 degrees F.

#### C. OCCUPIED CYCLE:

1. Run fan continuously with end of cycle valve full open.
2. Open unit outside air damper to scheduled minimum position.
3. Modulate face and bypass damper to maintain 72 degrees F in space.
4. As space temperature rises above 72 degrees F. shut face damper, and end of cycle valve and modulate unit O.A. damper and R.A. damper to maintain 74 degrees F. in space.

#### D. UN-OCCUPIED CYCLE:

1. Run fan only on call for heat to maintain 62 degrees F. in space.
2. Shut outside air dampers and return air dampers.
3. Open face and bypass dampers to full face when outside air is below 60 degrees F.

#### E. WARM UP CYCLE:

1. Run fan only on call for heat to maintain 72 degrees F. in space.
2. Shut O.A. damper, and open R.A. damper.
3. Open face and bypass dampers to full face when outside air is below 60 degrees F.

#### F. OCCUPANCY SENSORS :

1. Where indicated on electrical drawings, sensor shall close O.A. and open R.A. damper when room is unoccupied. Fan shall remain energized to maintain room temperature set point.

Maine Endwell Middle School 2011

Binghamton , New York

**AIR TEMP HEATING & AIR CONDITIONING, INC.**  
A LINC SERVICE @ CONTRACTOR

Unit Ventilators

REV: 1      Submittal      9/29/2008      JOB NO: P7619


**AUTOMATED LOGIC**  
CORPORATION

CHECK BY: RSL

DSCODE: 07112.00


# Unit Ventilators DX

Typical For 3 New Unit Ventilators

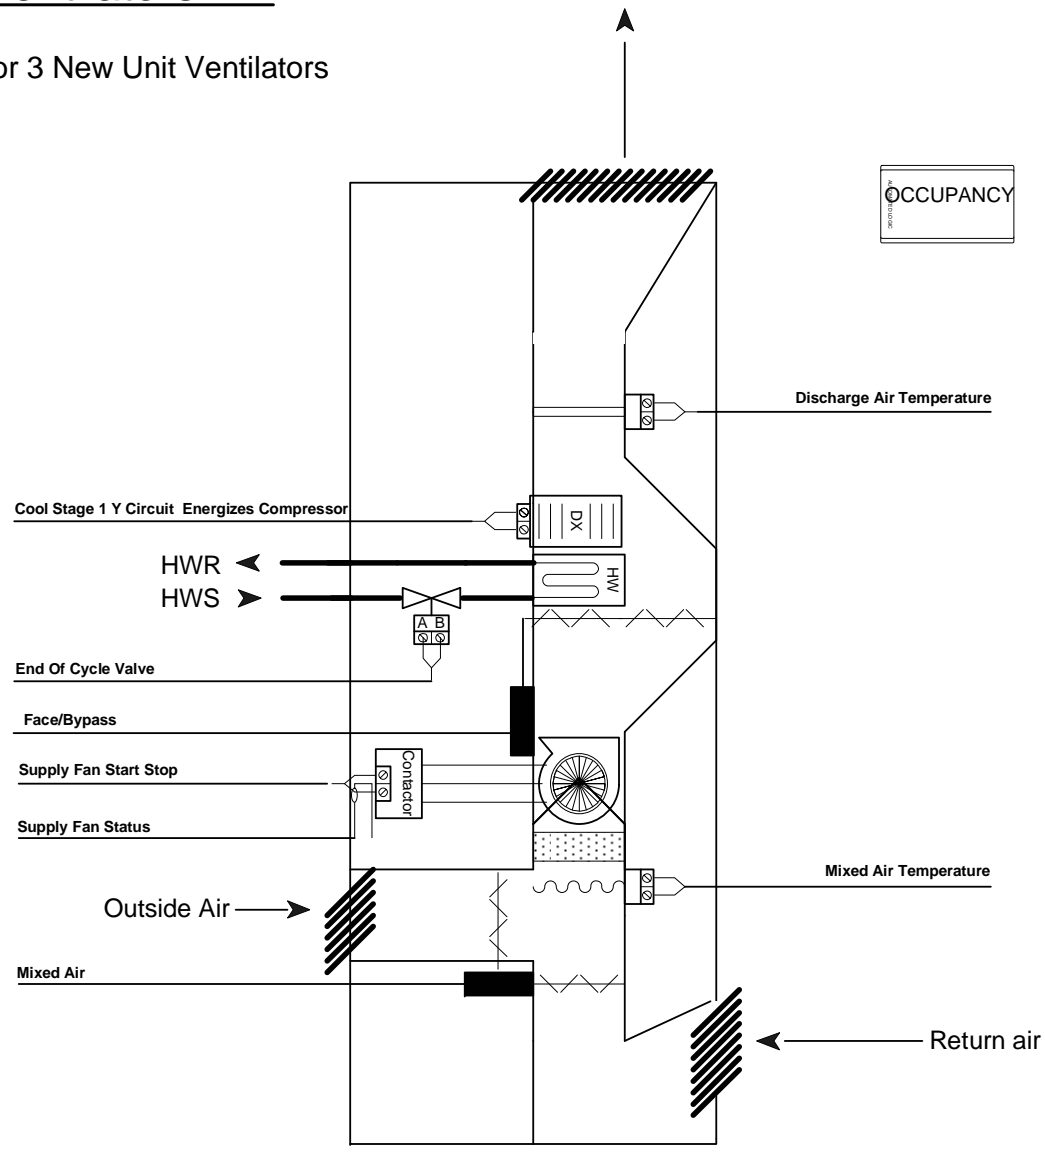

**SEE FOLLOWING PAGE FOR SEQUENCES**

Bill of Materials				
DID	DESCRIPTION	MANUFACTURER	PART NUMBER	QTY
DA-CE	SR 0-10VDC 35 IN-LB 24 V	BELIMO	LF24-SR ALC	6 ea
DTS-D	DUCT 10K THERMISTOR PROBE 8 IN.	BAPI	ALC/10K-2-D-8	3 ea
DTS-F	DUCT 10K THERMISTOR AVERAGING 8 FT.	BAPI	ALC/10K-2-A-8	3 ea
REL-BC	PILOT RELAY 24 VAC DPDT W/ LED	OMRON	LY2N-24V	6 ea
RIBXKF	.25 TO 150 CURRENT SENSOR	FUNCTIONAL DEVICES	RIBXKF	3 ea
RS	ROOM STAT	ALC	RS	3 ea
ZN253	ZN253	AUTOMATED LOGIC	ZN253	3 ea

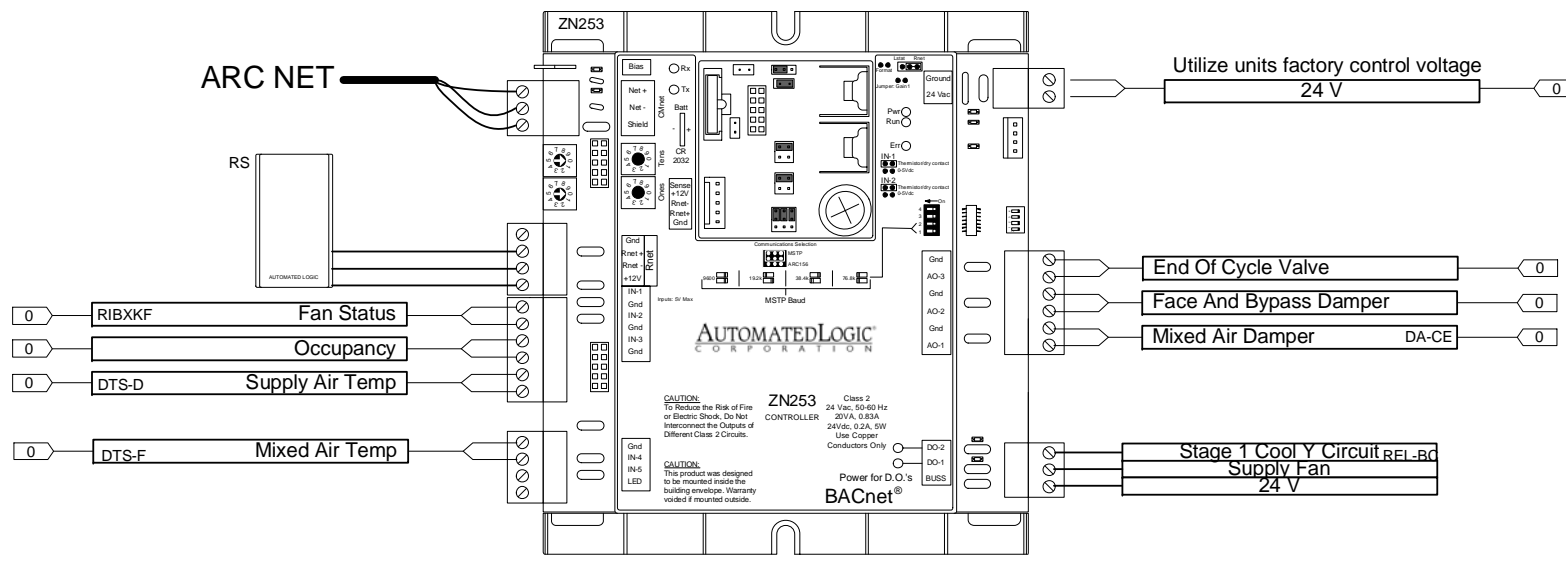

**Maine Endwell Middle School 2011**  
 Binghamton , New York  
**AIR TEMP HEATING & AIR CONDITIONING, INC.**  
 A LINC SERVICE @ CONTRACTOR  
**Unit Ventilators DX**

REV: 1	Submittal	9/29/2008	JOB NO: P7619
			CHECK BY: RSL
			DSCODE: 07112.00

**AUTOMATED LOGIC CORPORATION**

22 of 37

# UV DX Sequence

## A. GENERAL:

1. Provide field mounted controls.
2. Index unit to occupied and unoccupied cycles from BMS.
3. End of cycle valve is normally open and shall close when unit begins economizer mode.
4. Unit shall be automatically indexed to heating or cooling by BAS.
5. redundant OA damper applicable on ceiling hung units above 2000 cfm.
6. Control interlock shall prevent compressor from running when fan is off
7. A 5 deg. Dead-band shall be maintained between mechanical cooling and heating S.P.
8. E.O.C. valve shall close when outdoor air is above 40 deg and economizer is operating.

## B. SAFETIES:

1. Stop fan shut outside air damper open return air damper, open face damper, and generate and alarm at BMS when any of the following occur.

- A. Discharge air temp is above 130 degrees F.
- b. Discharge air temp is below 40 degrees F.
- C. .

## C. OCCUPIED CYCLE:

1. Run fan continuously with end of cycle valve full open. Redundant OA damper opens
2. Open unit outside air damper to scheduled minimum position.
3. Modulate face and bypass damper to maintain 72 degrees F in space.
4. As space temperature rises above 72 degrees F. shut face damper, and end of cycle valve and modulate unit O.A. damper and R.A. damper to maintain 74 degrees F. in space.

## D. UN-OCCUPIED CYCLE:

1. Run fan only on call for heat to maintain 55 degrees F. in space.
2. Shut outside air dampers and return air dampers.
3. Open face and bypass dampers to full face when outside air is below 60 degrees F.

## E. WARM UP CYCLE:

1. Run fan only on call for heat to maintain 72 degrees F. in space.
2. Shut O.A. damper, and open R.A. damper.
3. Open face and bypass dampers to full face when outside air is below 60 degrees F.

## F. OCCUPANCY SENSORS :

1. Where indicated on electrical drawings, sensor shall close O.A. and open R.A. damper when room is unoccupied. Fan shall remain energized to maintain room temperature set point.

## G. Occupied Cooling:

1. Supply fan shall run continuously, and redundant outside air damper shall open.
2. Outdoor air damper goes to minimum position.
3. Space sensor shall cycle condensing unit to maintain space temp. when outdoor air enthalpy permits free cooling outdoor air damper will open 100% and E.O.C. valve shall close.

## H. Unoccupied Cooling:



1. The outdoor air damper shall remain fully closed. Condensing unit shall be cycled to maintain 85 Deg. F.

## I. Cool Down:

1. The unit shall perform an optimized cool down prior to the occupied cooling mode.
2. During the cool down, the outside air dampers shall remain closed until the condensing unit obtains occupied S.P.

## J. Exhaust Fan Interlock:

1. When ever the exhaust serving the space is energized, the air handler shall be returned to occupied with outdoor air damper at 100% open.

Maine Endwell Middle School 2011 Binghamton , New York			
 AIR TEMP HEATING & AIR CONDITIONING, INC. A LINC SERVICE ® CONTRACTOR			
UV DX Sequence			
REV: 1	Submittal	9/29/2008	JOB NO: P7619
			CHECK BY: RSL
			DSCODE: 07112.00
			23 of 37

## Fan Coils A


- Total of 4  
 Area A 1st Floor Team Room  
 Area A 2nd Floor Team Room  
 Area C 1st Floor offices  
 Area B 1st Floor Food Service office

## Fan Coils B

- Total of 10  
 Area C 1st Floor Psych  
 Area B 2nd Floor Team Room  
 Area C 2nd Floor Team Room  
 Area C 2nd Floor Conference  
 Area C 1st Floor ALS  
 Area B 2nd Floor Team Room  
 Area B 2nd Floor Conference  
 Area B 2nd Floor Conference  
 Area C 2nd Floor Conference


## Bill of Materials

DID	DESCRIPTION	MANUFACTURER	PART NUMBER	QTY
CS-E	CURRENT SWITCH .5-200 AMP SOLID CORE GO/NO GO	VERUS IND.	H-800	14 ea
DTS-A	DUCT 10K THERMISTOR PROBE 12 IN.	BAPI	ALC/10K-2-D-12	14 ea
DTS-B	DUCT 10K THERMISTOR AVERAGING 12 FT.	BAPI	ALC/10K-2-A-12	14 ea
FS-D	TEMP LOW LIMIT MAN. RESET DPDT	LANDIS STEAFA	1341504	14 ea
LSPLUS	LOGISTAT 10K ROOM SENSOR W/ SETP ADJ, TLO, COMM	BAPI	LSPLUS	14 ea
REL-BC	PILOT RELAY 24 VAC DPDT W/ LED	OMRON	LY2N-24V	28 ea
TR-AG	TRANSFORMER, 120/24VAC 150VA W/CCT BREAKER	CORE COMPONENTS	LE-124	14 ea
ZN253	ZN253	AUTOMATED LOGIC	ZN253	14 ea

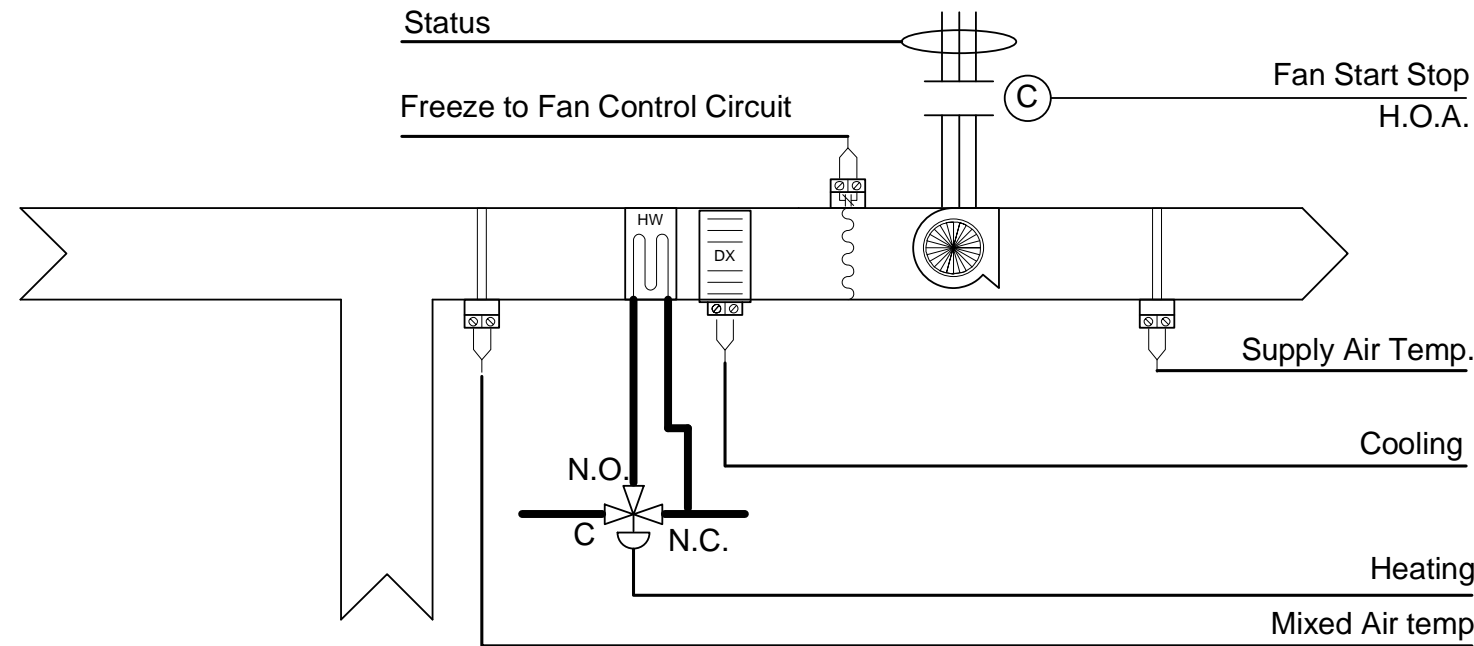

NOTE : Fan Coils will Be interlocked Via BACNET NETWORK TO CORRESPONDING EXHAUST

NOTE : Fan Coils B will Be interlocked Via BACNET NETWORK TO CORRESPONDING NON POWERED RV FOR OUTDOOR AIR DAMPER

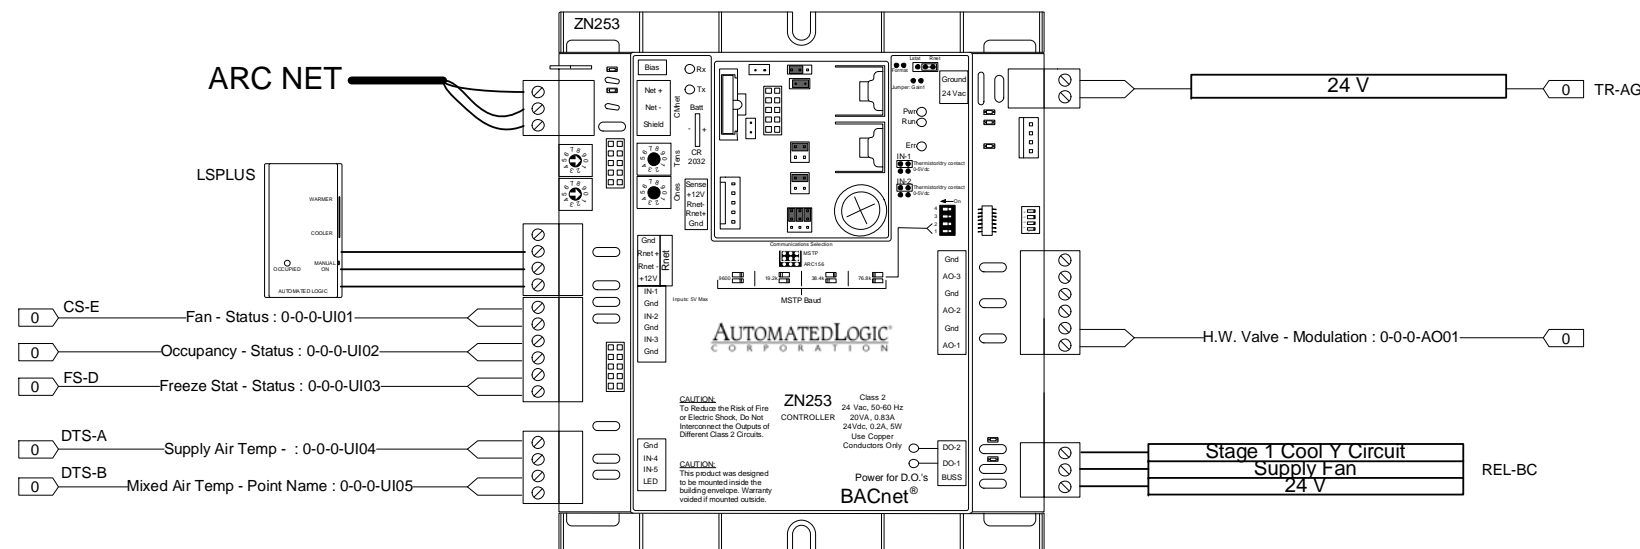

Maine Endwell Middle School 2011 Binghamton , New York			
 A LINC SERVICE @ CONTRACTOR			
Fan Coils A			
REV: 1	Submittal	9/29/2008	JOB NO: P7619
			CHECK BY: RSL
			DSCODE: 07112.00
			24 of 37



# Fan Coil A Sequence

## A. General

1. Unit shall be indexed to occupied and unoccupied by B.A.S.
2. A 5 degrees dead band shall be maintained between heating and mechanical cooling space temperature set points.

## B. Occupied Heating Cycle:

1. Supply fan shall run continuously
2. Space sensor shall modulate hot water valve to maintain occupied cycle set point.

## C. Unoccupied heating Cycle:

1. control valve will modulate in sequence with supply fan to maintain unoccupied set point.

## D. Warm Up Cycle:



1. The unit shall perform an optimized warm up prior to the start of the occupied mode.
2. During the warm up cycle the H.W. valve shall be 100% until occupied S.P. is obtained.

## C. Occupied Cycle Cooling:

1. Supply fan shall run continuously.
2. Space sensor shall cycle condensing unit to maintain occupied cycle set point.
4. Discharge air Low limit shall be disabled.

## D. Unoccupied Cycle Cooling:

1. The condensing unit and supply fan cycling to maintain unoccupied S.P.

Maine Endwell Middle School 2011 Binghamton , New York			
 <b>AIR TEMP HEATING &amp; AIR CONDITIONING, INC.</b> A LINC SERVICE @ CONTRACTOR			
Fan Coil A Sequence			
REV: 1	Submittal	9/29/2008	JOB NO: P7619
			CHECK BY: RSL
			DSCODE: 07112.00
			25 of 37

## Fan Coil A Sequence 2

### E. Cool Down Cycle:



1. The unit shall perform an optimized cool down prior to the start of the occupied mode.
2. During the cool down cycle the condensing unit will obtain occupied S.P.

### F. Exhaust Fan Interlock:

1. Where called for, whenever the interlocked exhaust fan is energized, the air handling unit shall be returned to occupied cycle

### G. Safeties:


1. Discharge air sensor shall indicate an alarm when high temperature discharge air is sensed through the coil ( 130 Deg. F.)
2. Low temperature limit shall de energize unit when low coil temperature is sensed ( 37 Deg. F.)
3. Fan shutdown shall be provided by the electrical contractor through the B.A.S.
4. Discharge air sensor shall assume control of valve to maintain minimum discharge air temperature of 55 Deg. F.

Maine Endwell Middle School 2011 Binghamton , New York			
 <b>AIR TEMP HEATING &amp; AIR CONDITIONING, INC.</b> A LINC SERVICE ® CONTRACTOR			
Fan Coil A Sequence 2			
REV: 1	Submittal	9/29/2008	JOB NO: P7619
			CHECK BY: RSL
			DSCODE: 07112.00
			26 of 37


# CUH/UH

Typical For 28 CUH's  
Typical For 9 UH's

Bill of Materials				
DID	DESCRIPTION	MANUFACTURER	PART NUMBER	QTY
CS-E	CURRENT SWITCH .5-200 AMP SOLID CORE GO/NO GO	VERUS IND.	H-800	28 ea
LSPLUS	LOGISTAT 10K ROOM SENSOR W/ SETP. ADJ, TLO, COMM	BAPI	LSPLUS	14 ea
REL-BC	PILOT RELAY 24 VAC DPDT W/ LED	OMRON	LY2N-24V	28 ea
TC-A	HW TEMP CONTROL HIGH LIMIT MAN. RESET	JOHNSON CONTROLS	A19ADB-2	28 ea
TR-AG	TRANSFORMER, 120/24VAC 150VA W/CCT BREAKER	CORE COMPONENTS	LE-124	28 ea
ZN220	ZN220	AUTOMATED LOGIC	ZN220	14 ea

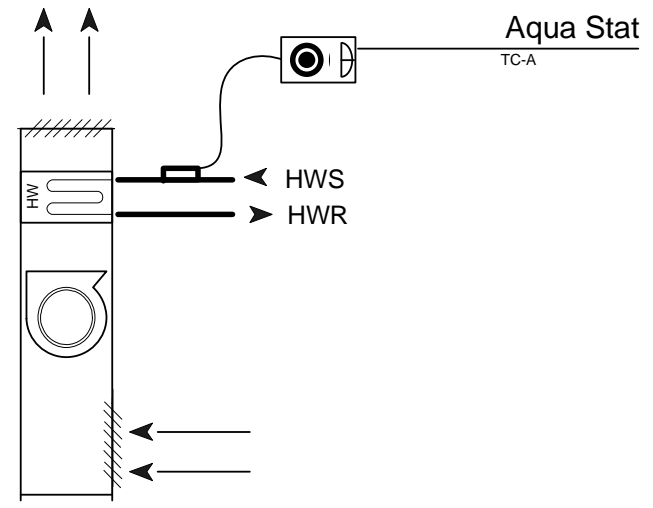

**CABINET HEATER**

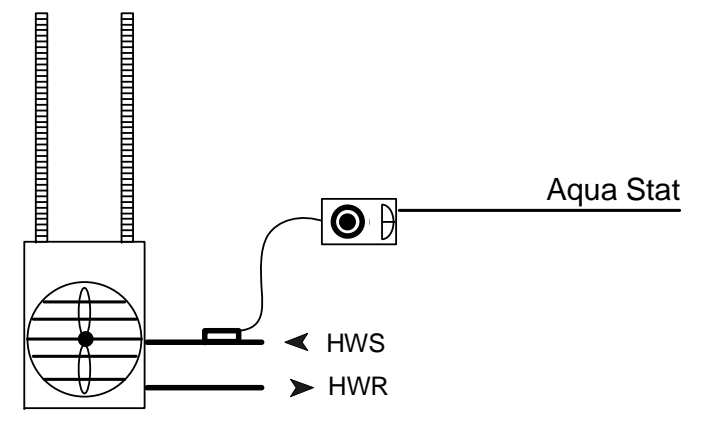

**UNIT HEATER**

**UH & CUH SEQUENCE**

**A. General**


1. Unit shall be provided with field mounted controls.
2. Aquastat shall de-energize unit when water temperature is less than 110 degrees F
3. The supply fan shall cycle to maintain space temperature.

**B. Occupied**

1. When the B.A.S. system places the system in the occupied mode, the supply fan shall cycle to maintain occupied temperature requirement of 68 degrees.

**C. Unoccupied**

1. When the B.A.S. system places the system in unoccupied mode, the supply fan shall cycle to maintain unoccupied temperature requirement of 55 degrees
2. System shall have the capability of overriding the unoccupied mode and returning to occupied for a period of 1 HR.

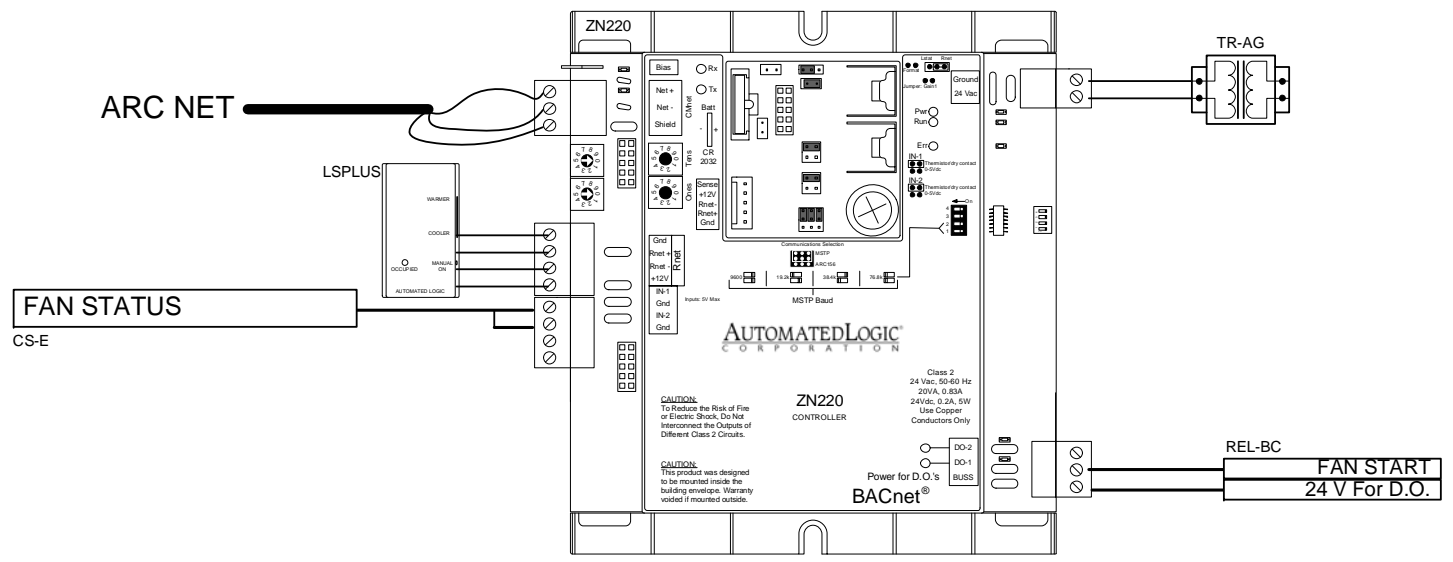

Maine Endwell Middle School 2011  
Binghamton, New York

**AIR TEMP HEATING & AIR CONDITIONING, INC.**  
A LINC SERVICE @ CONTRACTOR

CUH/UH

REV: 1	Submittal	9/29/2008	JOB NO: P7619
--------	-----------	-----------	---------------


CHECK BY: RSL  
DSCODE: 07112.00

**AUTOMATED LOGIC**  
CORPORATION


27 of 37

# CUH OUTDOOR AIR

Typical For 27 CUH's

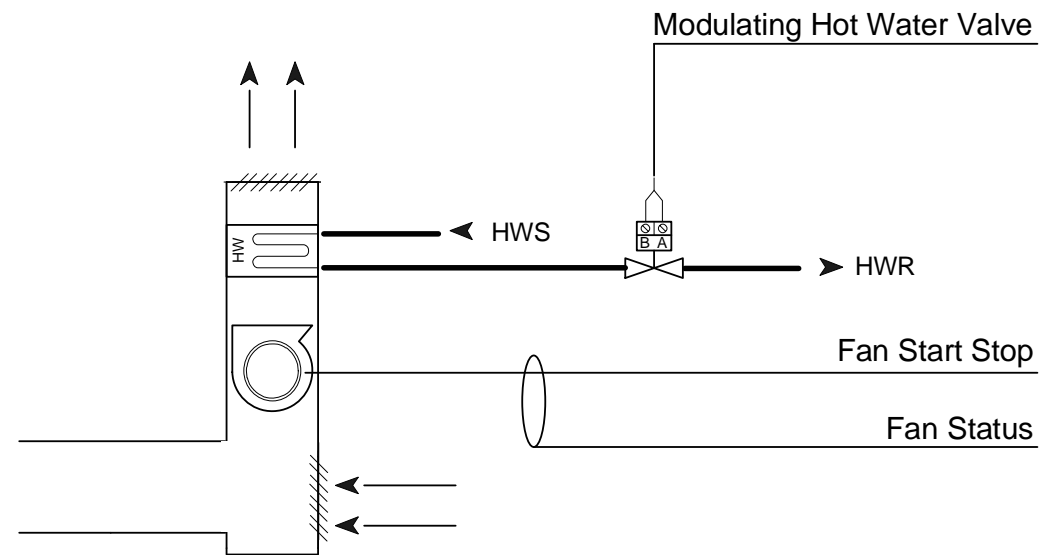

## CABINET HEATER

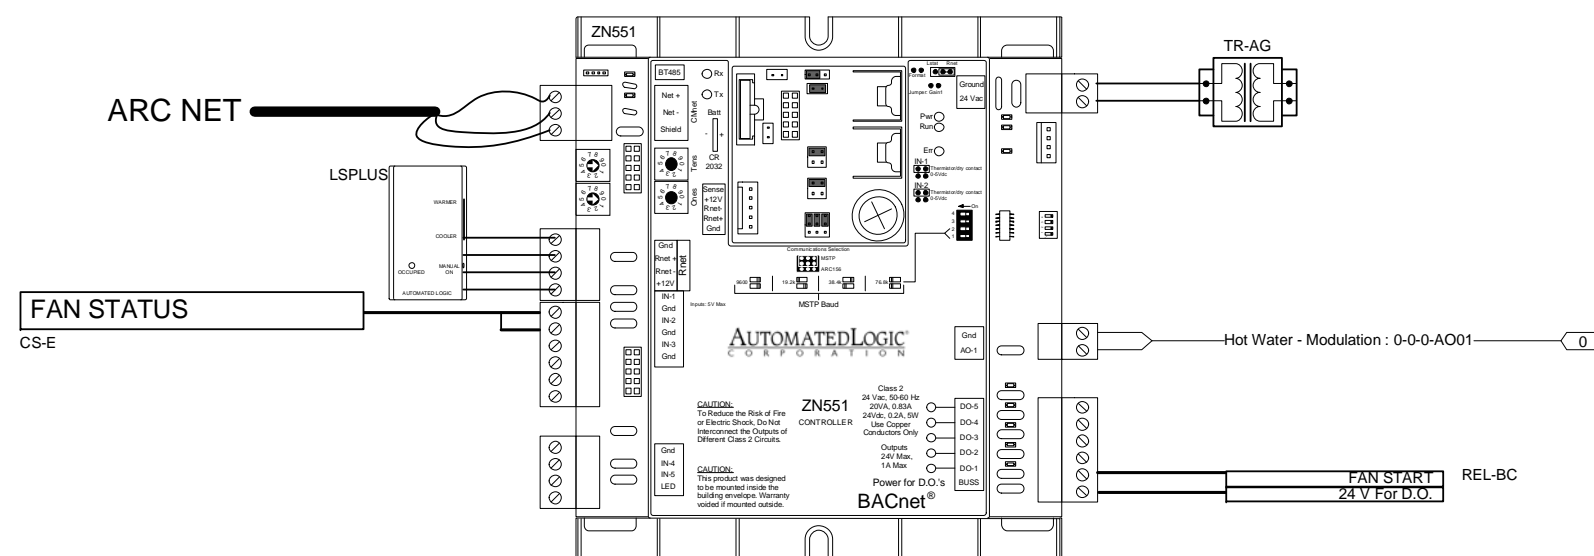

## Bill of Materials

DID	DESCRIPTION	MANUFACTURER	PART NUMBER	QTY
CS-E	CURRENT SWITCH .5-200 AMP SOLID CORE GO/NO GO	VERUS IND.	H-800	27 ea
LSPLUS	LOGISTAT 10K ROOM SENSOR W/ SETP. ADJ, TLO, COMM	BAPI	LSPLUS	13 ea
REL-BC	PILOT RELAY 24 VAC DPDT W/ LED	OMRON	LY2N-24V	54 ea
TR-AG	TRANSFORMER, 120/24VAC 150VA W/CCT BREAKER	CORE COMPONENTS	LE-124	27 ea
ZN551	ZN551	AUTOMATED LOGIC	ZN551	27 ea

### UH & CUH SEQUENCE

#### A. General

1. Unit shall be provided with field mounted controls.
2. Aquastat shall de-energize unit when water temperature is less than 110 degrees F
3. The supply fan shall cycle to maintain space temperature.

#### B. Occupied

1. When the B.A.S. system places the system in the occupied mode, the supply fan shall cycle to maintain occupied temperature requirement of 68 degrees.

#### C. Unoccupied

1. When the B.A.S. system places the system in unoccupied mode, the supply fan shall cycle to maintain unoccupied temperature requirement of 55 degrees
2. System shall have the capability of overriding the unoccupied mode and returning to occupied for a period of 1 HR.

Maine Endwell Middle School 2011

Binghamton, New York

**AIR TEMP HEATING & AIR CONDITIONING, INC.**  
A LINC SERVICE @ CONTRACTOR

CUH OUTDOOR AIR

REV: 1	Submittal	9/29/2008	JOB NO: P7619
--------	-----------	-----------	---------------



**AUTOMATED LOGIC**  
CORPORATION

CHECK BY: RSL

DSCODE: 07112.00

# Exhaust Fans

Typical for 32

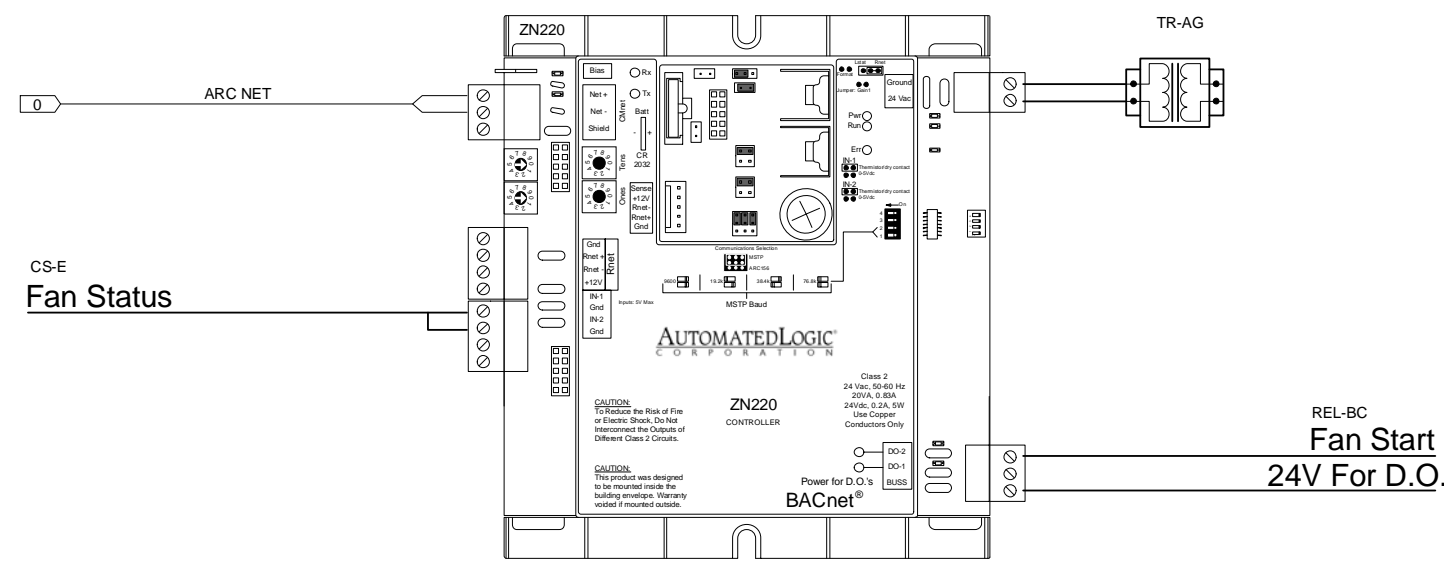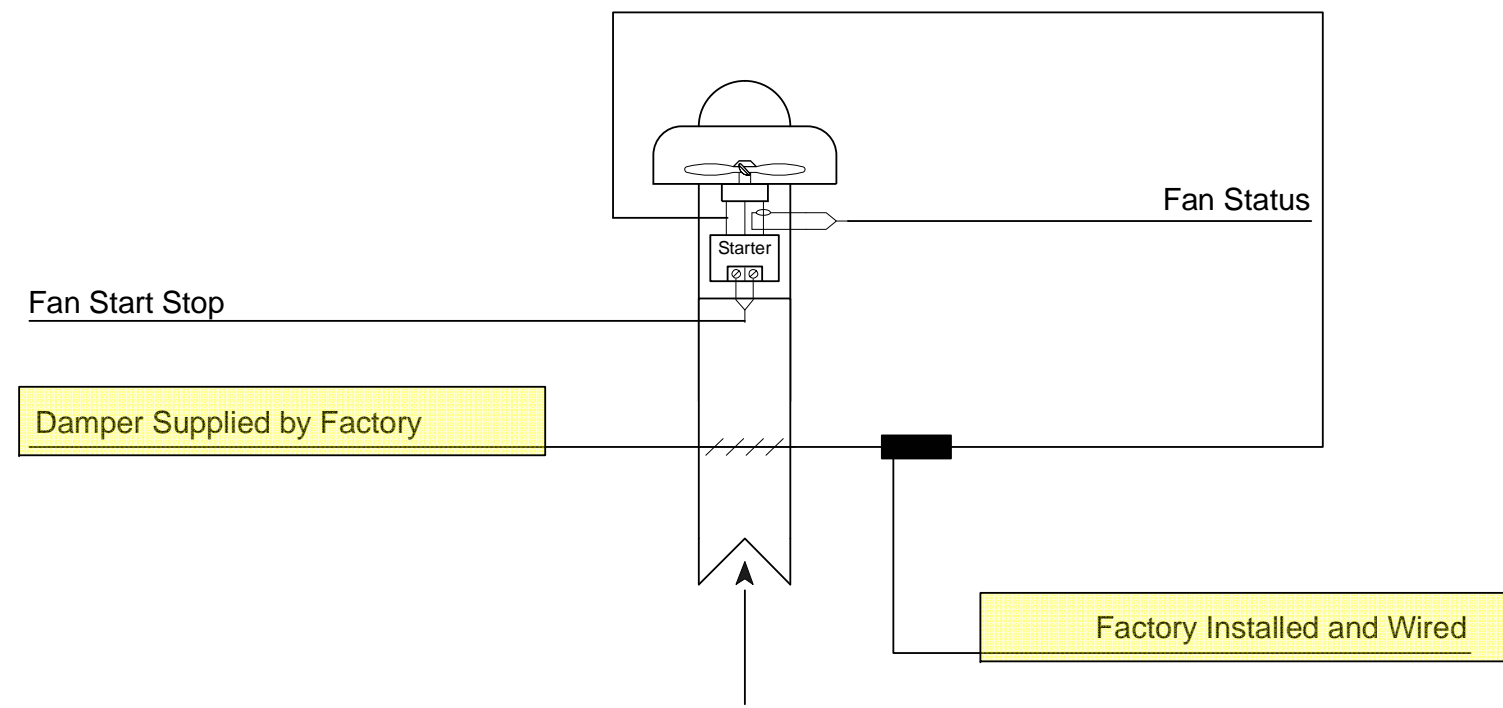

Bill of Materials				
DID	DESCRIPTION	MANUFACTURER	PART NUMBER	QTY
CS-E	CURRENT SWITCH .5-200 AMP SOLID CORE GO/NO GO	VERUS IND.	H-800	30 ea
REL-BC	PILOT RELAY 24 VAC DPDT W/ LED	OMRON	LY2N-24V	30 ea
TR-AG	TRANSFORMER, 120/24VAC 150VA W/CCT BREAKER	CORE COMPONENTS	LE-124	15 ea
ZN220	ZN220	AUTOMATED LOGIC	ZN220	15 ea

Coordinate with EC and MC for automatic dampers & actuators and associated wiring. Reference specification section 15910, 3.01 and the fan schedule for requirements and responsibilities


### EXHAUST FAN CONTROL

1. fan shall be energized by BAS during occupied mode, and off during unoccupied mode.
2. Automatic damper shall open when fan is energized and close when fan is off.
3. Damper actuator to be electric.

Maine Endwell Middle School 2011 Binghamton , New York			
A LINC SERVICE @ CONTRACTOR			
Exhaust Fans			
REV: 1	Submittal	9/29/2008	JOB NO: P7619
			CHECK BY: RSL
			DSCODE: 07112.00
29 of 37			

## Exhaust Fans 2

F-37 Serves M1-12.4 Electrical Room  
F-38 M1-2.1 MACH Room

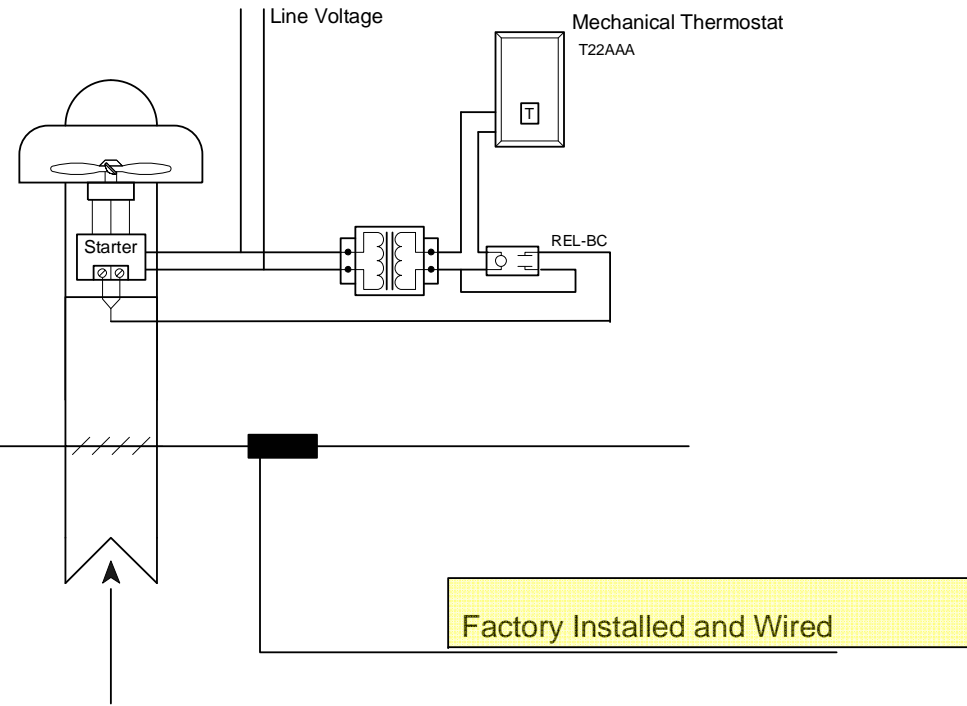

### Bill of Materials

DID	DESCRIPTION	MANUFACTURER	PART NUMBER	QTY
REL-BC	PILOT RELAY 24 VAC DPDT W/ LED	OMRON	LY2N-24V	2 ea
T22AAA	LINE VOLTAGE WALL THERMOSTAT SPST	JOHNSON CONTROLS	T22AAA-1	2 ea

Coordinate with EC and MC for automatic dampers & actuators and associated wiring. Reference specification section 15910, 3.01 and the fan schedule for requirements and responsibilities

#### ***EXHAUST FAN CONTROL***

1. fan shall be energized by a reverse acting mechanical thermostat.
2. Automatic damper shall open when fan is energized and close when fan is off.
3. Damper actuator to be electric.

Maine Endwell Middle School 2011

Binghamton , New York

 **AIR TEMP HEATING & AIR CONDITIONING, INC.**  
A LINC SERVICE @ CONTRACTOR

Exhaust Fans 2

REV: 1	Submittal	9/29/2008	JOB NO: P7619
--------	-----------	-----------	---------------

**AUTOMATEDLOGIC**  
CORPORATION


CHECK BY: RSL

DSCODE: 07112.00

30 of 37

# Power Relief

Typical for 32

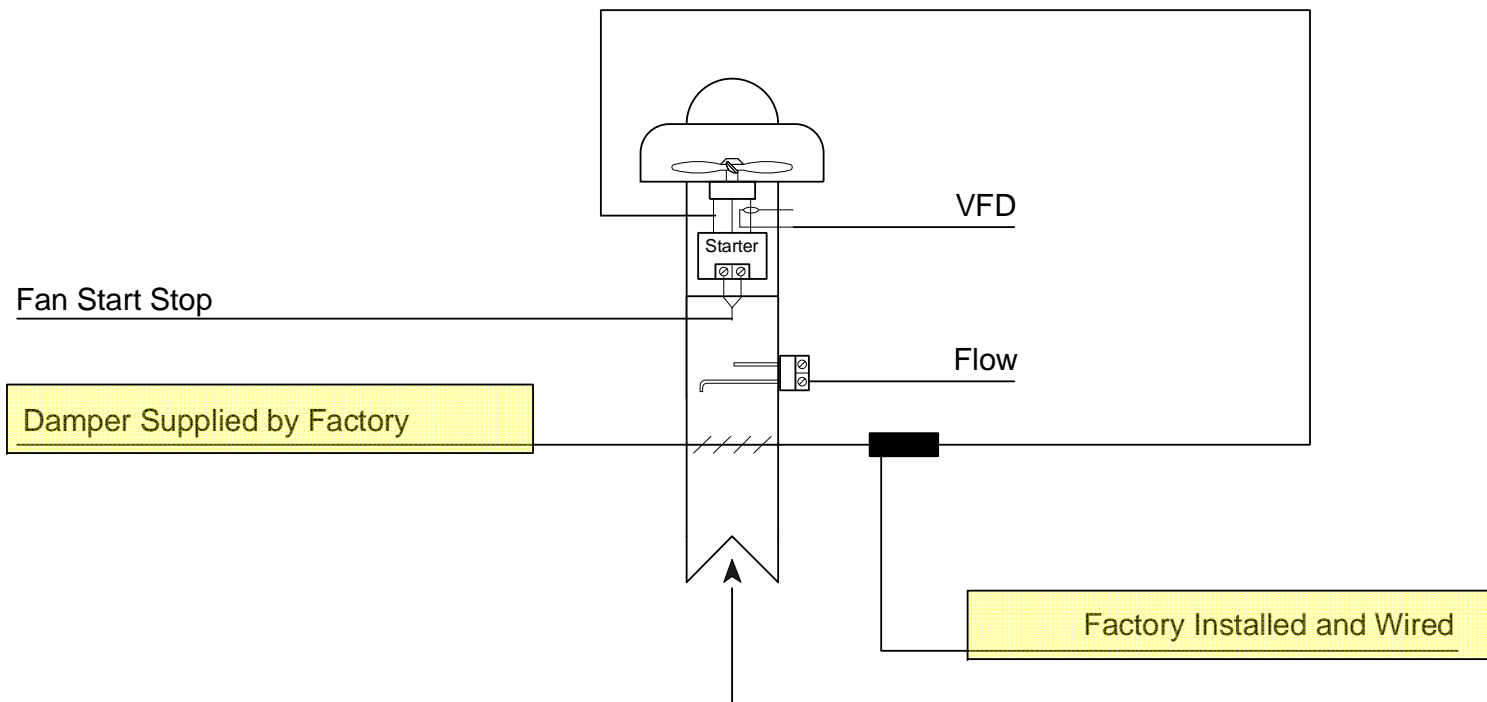


- 1MS
- 4MS
- 5MS
- 7MS
- 8MS
- 9MS
- 10MS
- 11MS
- 12MS
- 13MS
- 15MS
- 16MS
- 17MS
- 20MS
- 21MS
- 22MS
- 23MS
- 25MS
- 26MS
- 31MS
- 32MS
- 33MS
- 35MS
- 36MS

Coordinate with EC and MC for automatic dampers & actuators and associated wiring. Reference specification section 15910, 3.01 and the fan schedule for requirements and responsibilities

### Power Relief Sequence

1. Automatic damper goes to 100% open when any associated U.V. runs during the occupied cycle.
2. The exhaust fan shall be controlled by the variable speed drive to maintain speed proportional to the outside air damper %
3. For control of single room eliminate variable speed drive and provide fan with 2 speed motor. Damper fully opens when U.V. runs in occupied cycle. Fan runs at low speed when U.V. O.A. damper is at minimum position. Fan runs at high speed when U.V. goes into economizer operation.

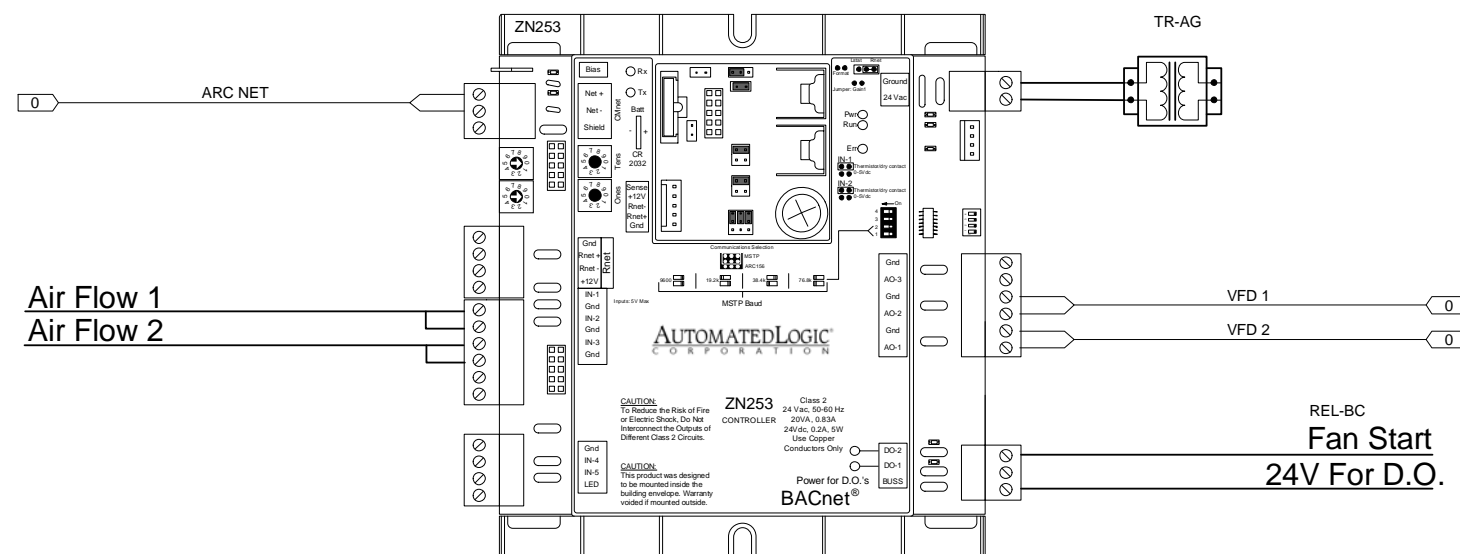

### Bill of Materials

DID	DESCRIPTION	MANUFACTURER	PART NUMBER	QTY
REL-BC	PILOT RELAY 24 VAC DPDT W/ LED	OMRON	LY2N-24V	30 ea
TR-AG	TRANSFORMER, 120/24VAC 150VA W/CCT BREAKER	CORE COMPONENTS	LE-124	15 ea
ZN253	ZN253	AUTOMATED LOGIC	ZN253	12 ea

Maine Endwell Middle School 2011

Binghamton, New York

**AIR TEMP HEATING & AIR CONDITIONING, INC.**  
A LINC SERVICE @ CONTRACTOR

Power Relief

REV: 1	Submittal	9/29/2008	JOB NO: P7619
--------	-----------	-----------	---------------


**AUTOMATED LOGIC CORPORATION**

CHECK BY: RSL

DSCODE: 07112.00

# Roof Vents

**DAMPER IS FACTORY SUPPLIED  
24 VOLT ACTUATORS ARE FACTORY SUPPLIED**

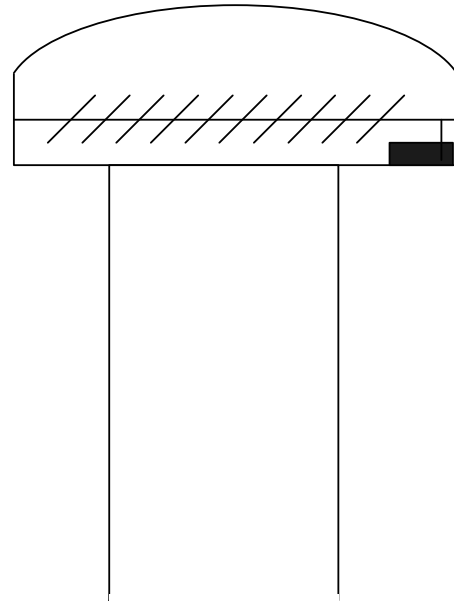


Bill of Materials				
DID	DESCRIPTION	MANUFACTURER	PART NUMBER	QTY
TR-AG	TRANSFORMER, 120/24VAC 150VA W/CCT BREAKER	CORE COMPONENTS	LE-124	12 ea
ZN220	ZN220	AUTOMATED LOGIC	ZN220	12 ea

Coordinate with EC and MC for automatic dampers & actuators and associated wiring. Reference specification section 15910, 3.01 and the fan schedule for requirements and responsibilities

NOTE. NON POWERED RV'S THAT ARE DUCTED TO FAN COILS WILL FOLLOW FAN COIL SEQUENCE

**ROOF VENT CONTROL**

1. Damper shall be energized by BAS during occupied mode, and off during unoccupied mode.
2. Damper actuator to be electric.

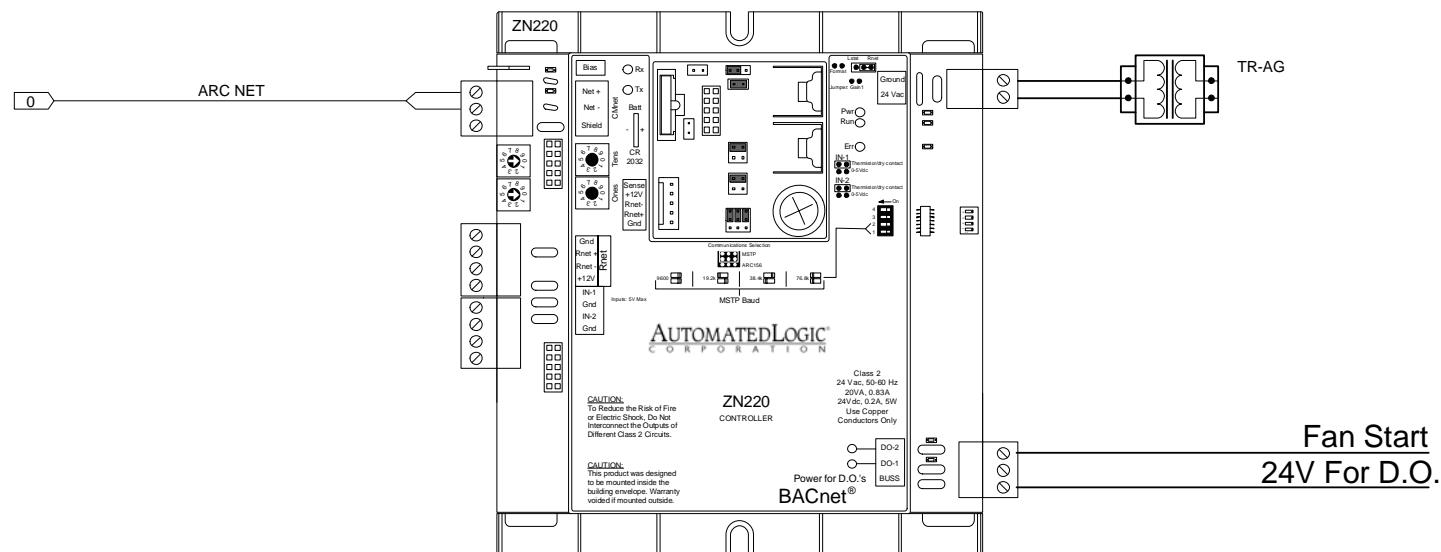

Maine Endwell Middle School 2011  
Binghamton , New York

**AIR TEMP HEATING & AIR CONDITIONING, INC.**  
A LINC SERVICE @ CONTRACTOR


Roof Vents

REV: 1	Submittal	9/29/2008	JOB NO: P7619
AUTOMATEDLOGIC CORPORATION			CHECK BY: RSL
AUTOMATEDLOGIC CORPORATION			DSCODE: 07112.00
32 of 37			



# Fin Tube


Bill of Materials				
DID	DESCRIPTION	MANUFACTURER	PART NUMBER	QTY
LSPLUS	LOGISTAT 10K ROOM SENSOR W/ SETP ADJ, TLO, COMM	BAPI	LSPLUS	4 ea
TR-AG	TRANSFORMER, 120/24VAC 150VA W/CCT BREAKER	CORE COMPONENTS	LE-124	4 ea
ZN220	ZN220	AUTOMATED LOGIC	ZN220	4 ea

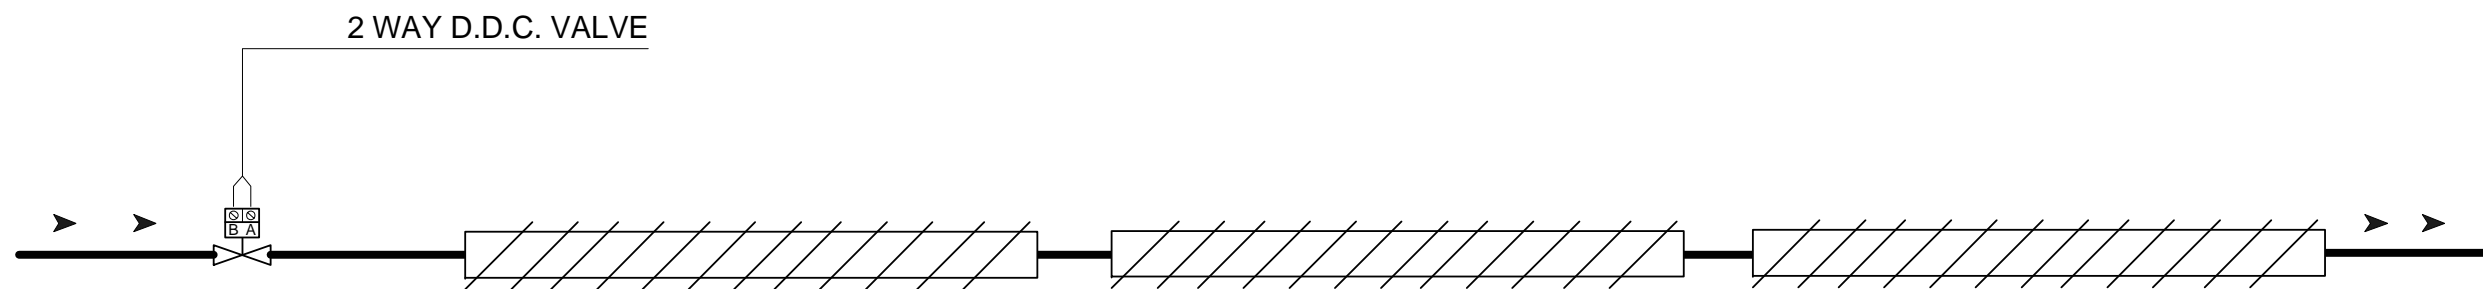

- RM M111M 6FT
- RM M111R 4.5FT
- RM M109L 6.6FT
- RM M109M 4.0FT

## FTR CONTROL

- A. Sequence Occupied
  1. D.D.C. Valve shall open to maintain occupied set point.
  2. Set point is adjustable at room sensor. Set point adjust can be limited, or disabled by operator.
- B. Sequence Unoccupied
  1. D.D.C. Valve shall remain closed. If room space temp drops below the unoccupied set point, valve shall open to maintain unoccupied set point.
  2. When override button is pushed on the wall mounted space temp sensor, the room shall operate as occupied until the override timer has expired. Override time is adjustable by operator

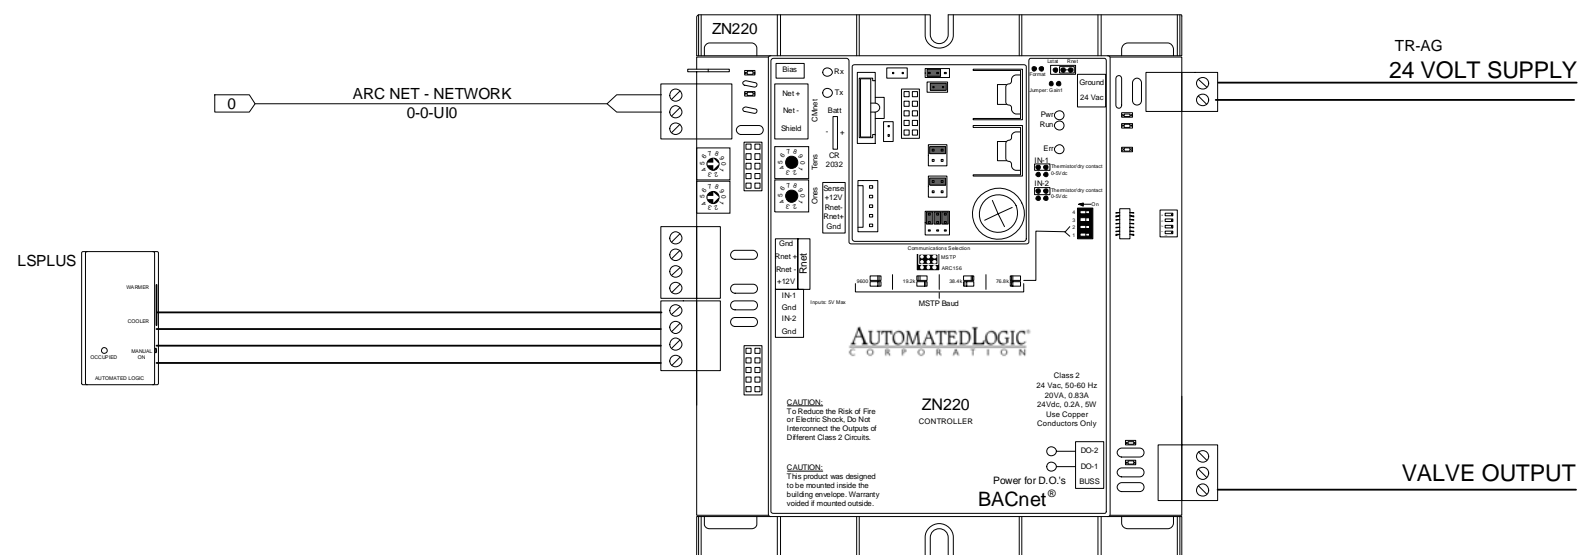


Maine Endwell Middle School 2011 Binghamton , New York			
 A LINC SERVICE @ CONTRACTOR			
Fin Tube			
REV: 1	Submittal	9/29/2008	JOB NO: P7619
			CHECK BY: RSL
			DSCODE: 07112.00
			33 of 37

# Fin Tube Existing

C Wing Stairwell

## Bill of Materials

DID	DESCRIPTION	MANUFACTURER	PART NUMBER	QTY
LSPLUS	LOGISTAT 10K ROOM SENSOR W/ SETP ADJ, TLO, COMM	BAPI	LSPLUS	1 ea
TR-AG	TRANSFORMER, 120/24VAC 150VA W/CCT BREAKER	CORE COMPONENTS	LE-124	1 ea
ZN220	ZN220	AUTOMATED LOGIC	ZN220	1 ea

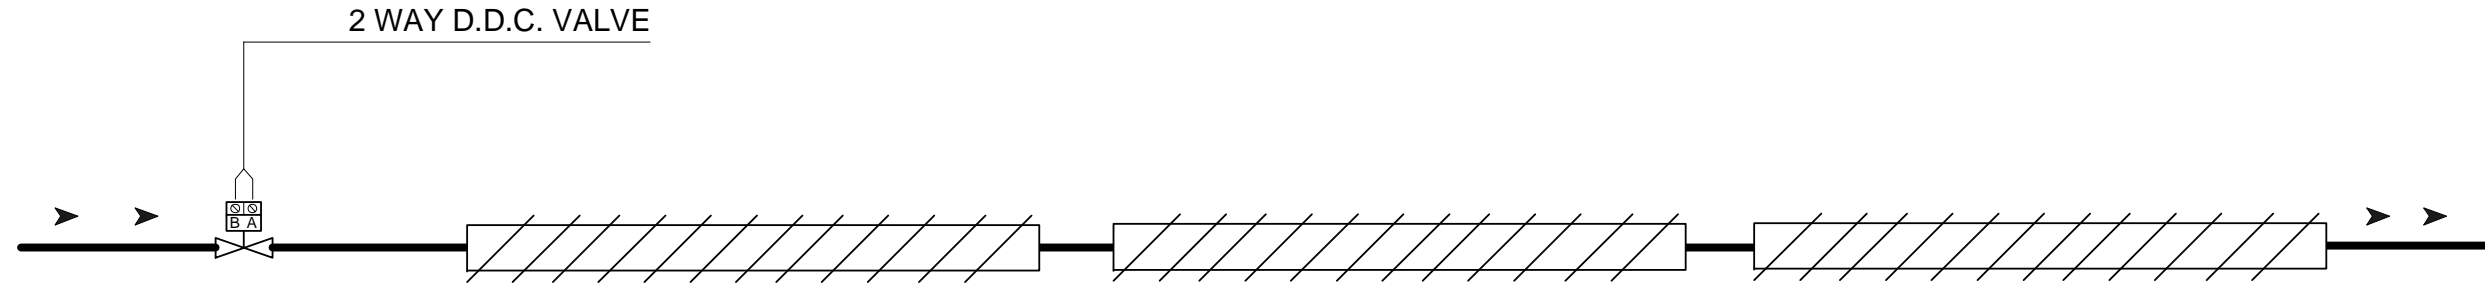


### FTR CONTROL

#### A. Sequence Occupied

1. D.D.C. Valve shall open to maintain occupied set point.
2. Set point is adjustable at room sensor. Set point adjust can be limited, or disabled by operator.

#### B. Sequence Unoccupied

1. D.D.C. Valve shall remain closed. If room space temp drops below the unoccupied set point, valve shall open to maintain unoccupied set point.
2. When override button is pushed on the wall mounted space temp sensor, the room shall operate as occupied until the override timer has expired. Override time is adjustable by operator

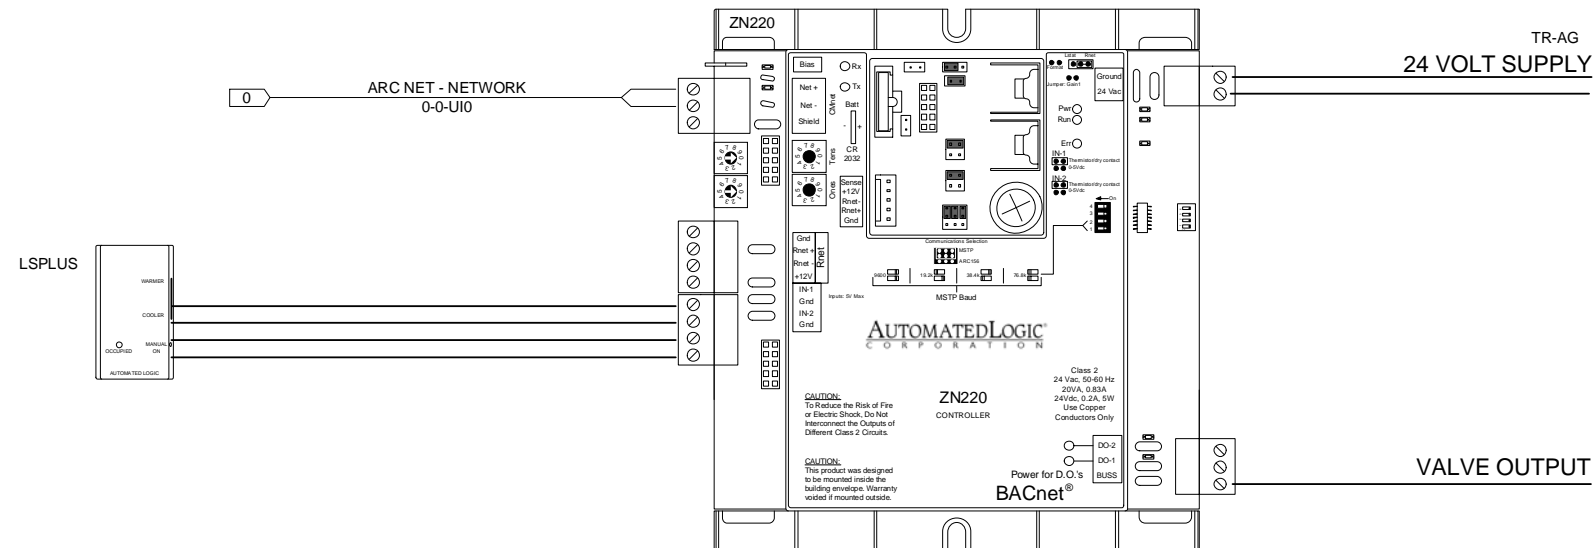


Maine Endwell Middle School 2011 Binghamton , New York			
A LINC SERVICE @ CONTRACTOR			
Fin Tube Existing			
REV: 1	Submittal	9/29/2008	JOB NO: P7619
			CHECK BY: RSL
			DSCODE: 07112.00
			34 of 37





fp

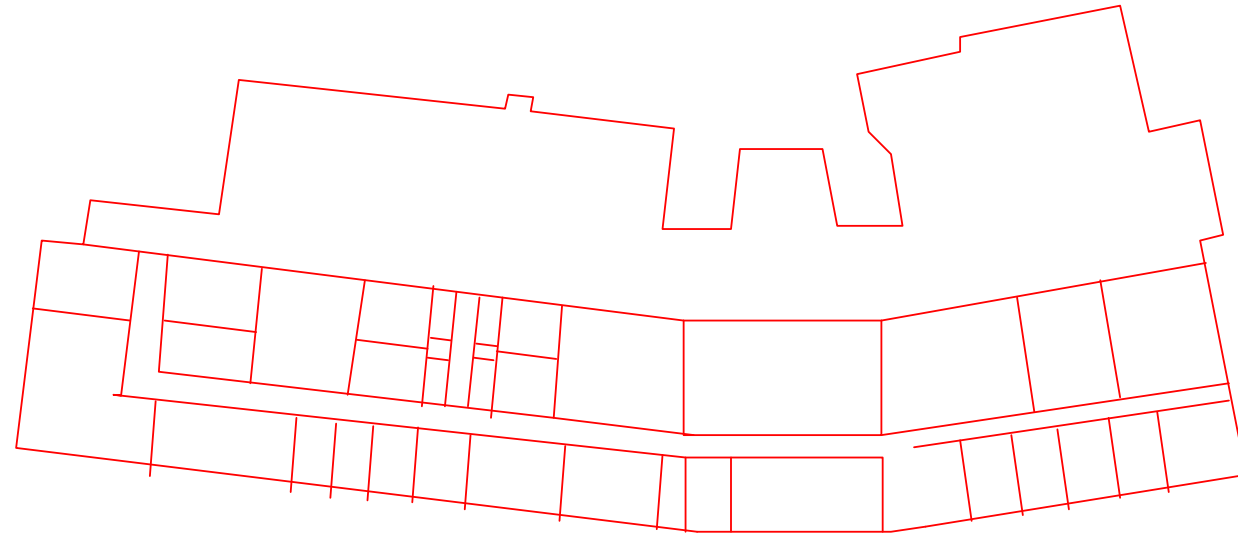

Maine Endwell Middle School 2011

Binghamton , New York

 **AIR TEMP HEATING & AIR CONDITIONING, INC.**  
A LINC SERVICE ® CONTRACTOR

fp

REV: 1	Submittal	9/29/2008	JOB NO: P7619
--------	-----------	-----------	---------------

**AUTOMATEDLOGIC**  
CORPORATION

CHECK BY: RSL

DSCODE: 07112.00